


G-4400 14

T.38S.R.10&11½E.W.M.

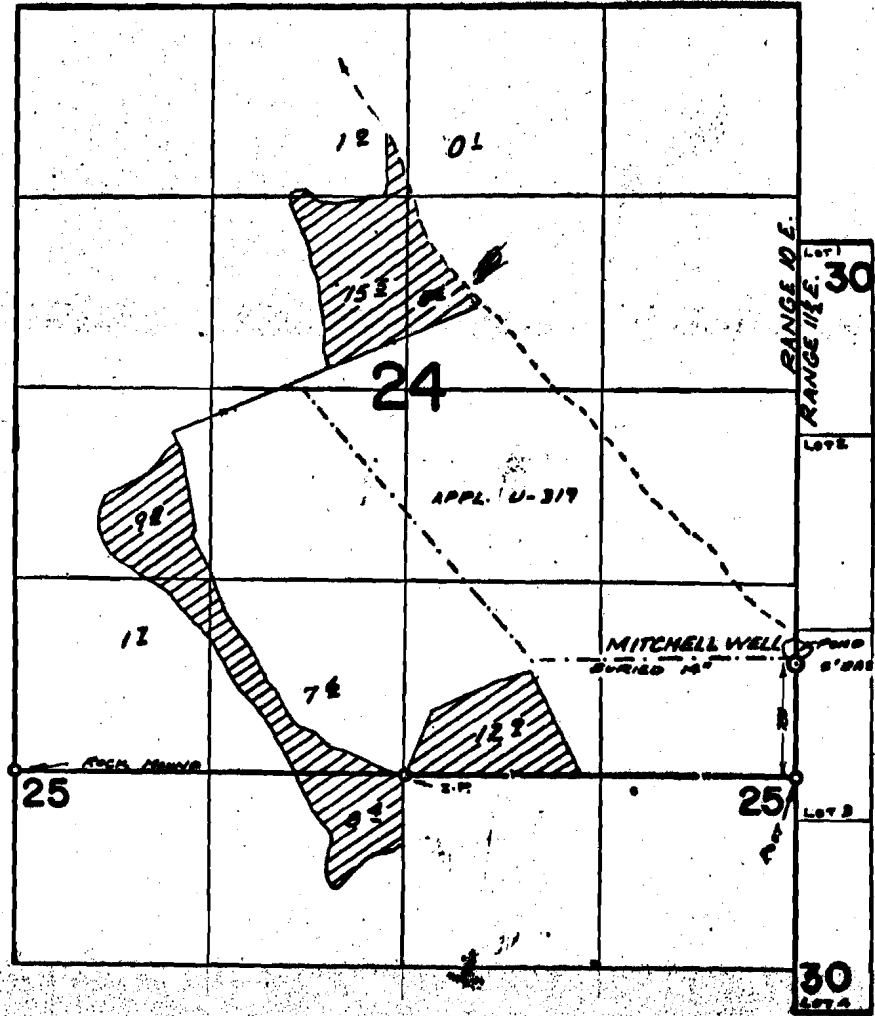

Swan Lake wells

FINAL PROOF SURVEY UNDER

Application No. G-4672, Permit No. G-4400
IN NAME OF

NEVIN CATTLE COMPANY
a corporation

Surveyed MAY 12, 1920, by R. MICKEN