


G-4404
38246

T.38S.R.11½E.W.M

Swan Lake wells

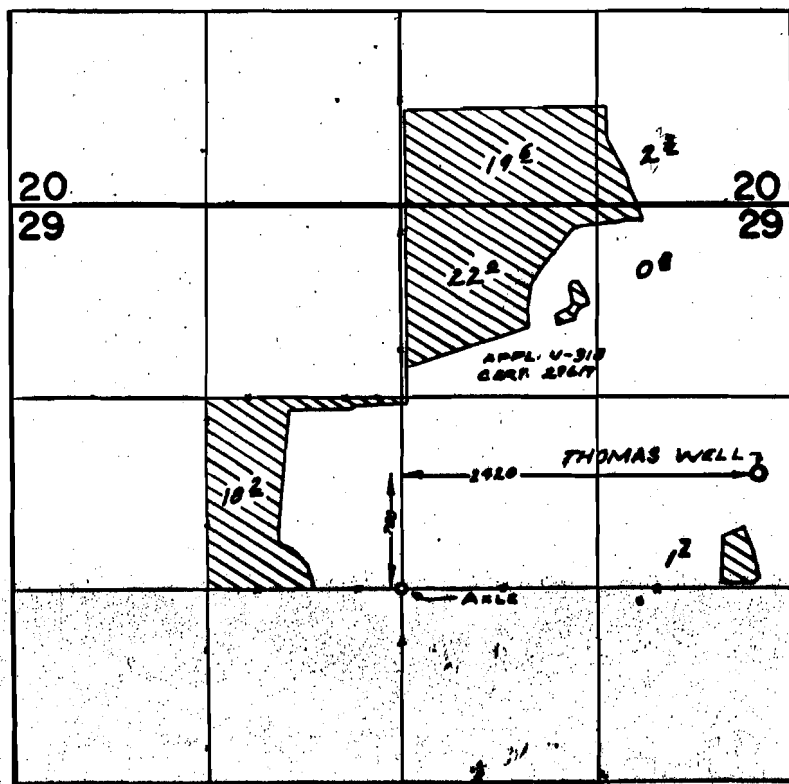

FINAL PROOF SURVEY UNDER

Application No. G-4673 Permit No. G-4404
IN NAME OF

NEVIN CATTLE COMPANY
a corporation

Surveyed MAY 12, 1970, by R. MUCKEN