

T.40S. R.14 $\frac{1}{2}$ E.W.M.

R-2318
38247

28

FINAL PROOF SURVEY


UNDER

Application No. R-21443 Permit No. R-2318
21444 26636

IN NAME OF

Johnson Stock Co. &
Charles, Silas W. & Louisa Kilgore

Surveyed Oct 8 1966, by W. J. Ruppert

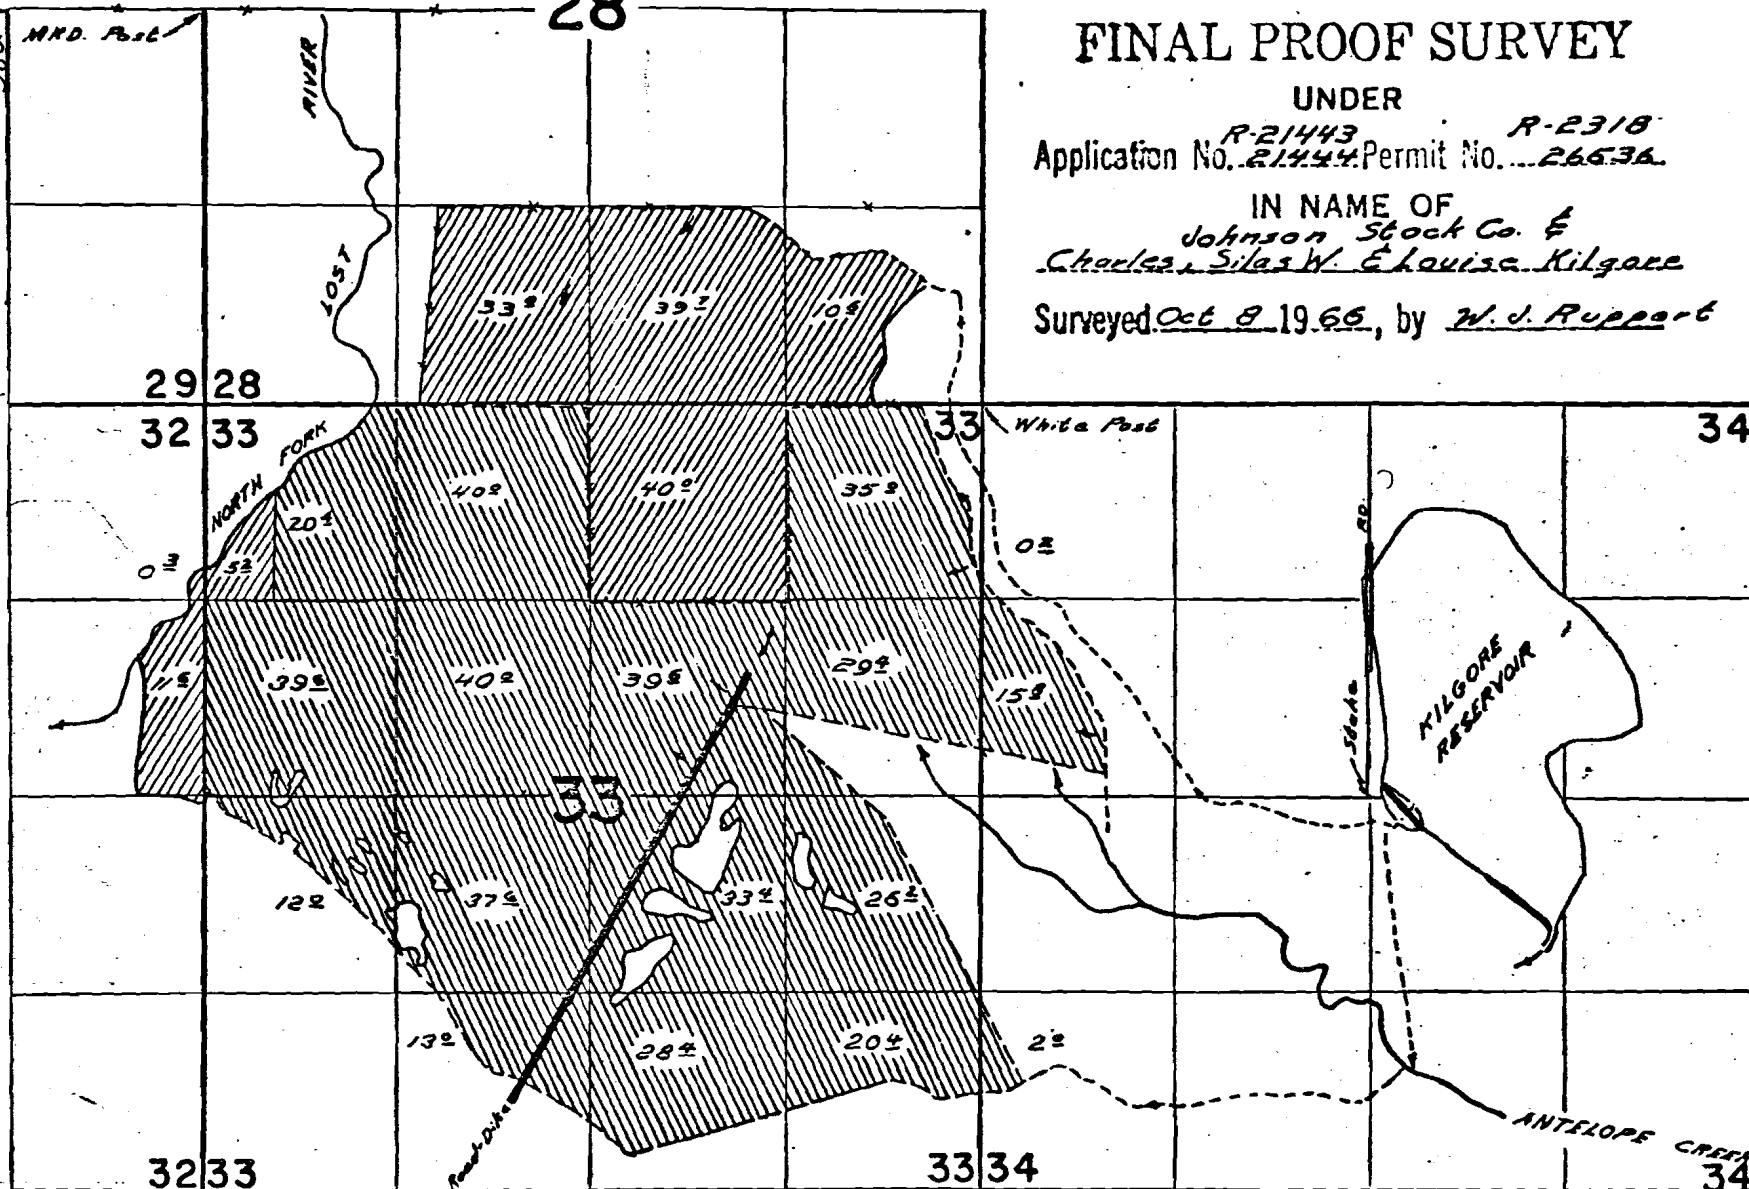

Primary Supplemental

Dir. Pt. located 130 SE. S. & 230 SE. E.
from Center Sec 34.

3. B. 1/2 Sec 34 & 1/2 Sec 35