

T. 40 S. R. 14 $\frac{1}{2}$ E. W. M.

FINAL PROOF SURVEY


UNDER

Application No. R-21443 Permit No. R-2318
E-1444 26636

IN NAME OF

Johnson Stock Co. &
Charles, Silas W. & Louise Kilgore

Surveyed Oct 8 1966, by W. J. Ruppert

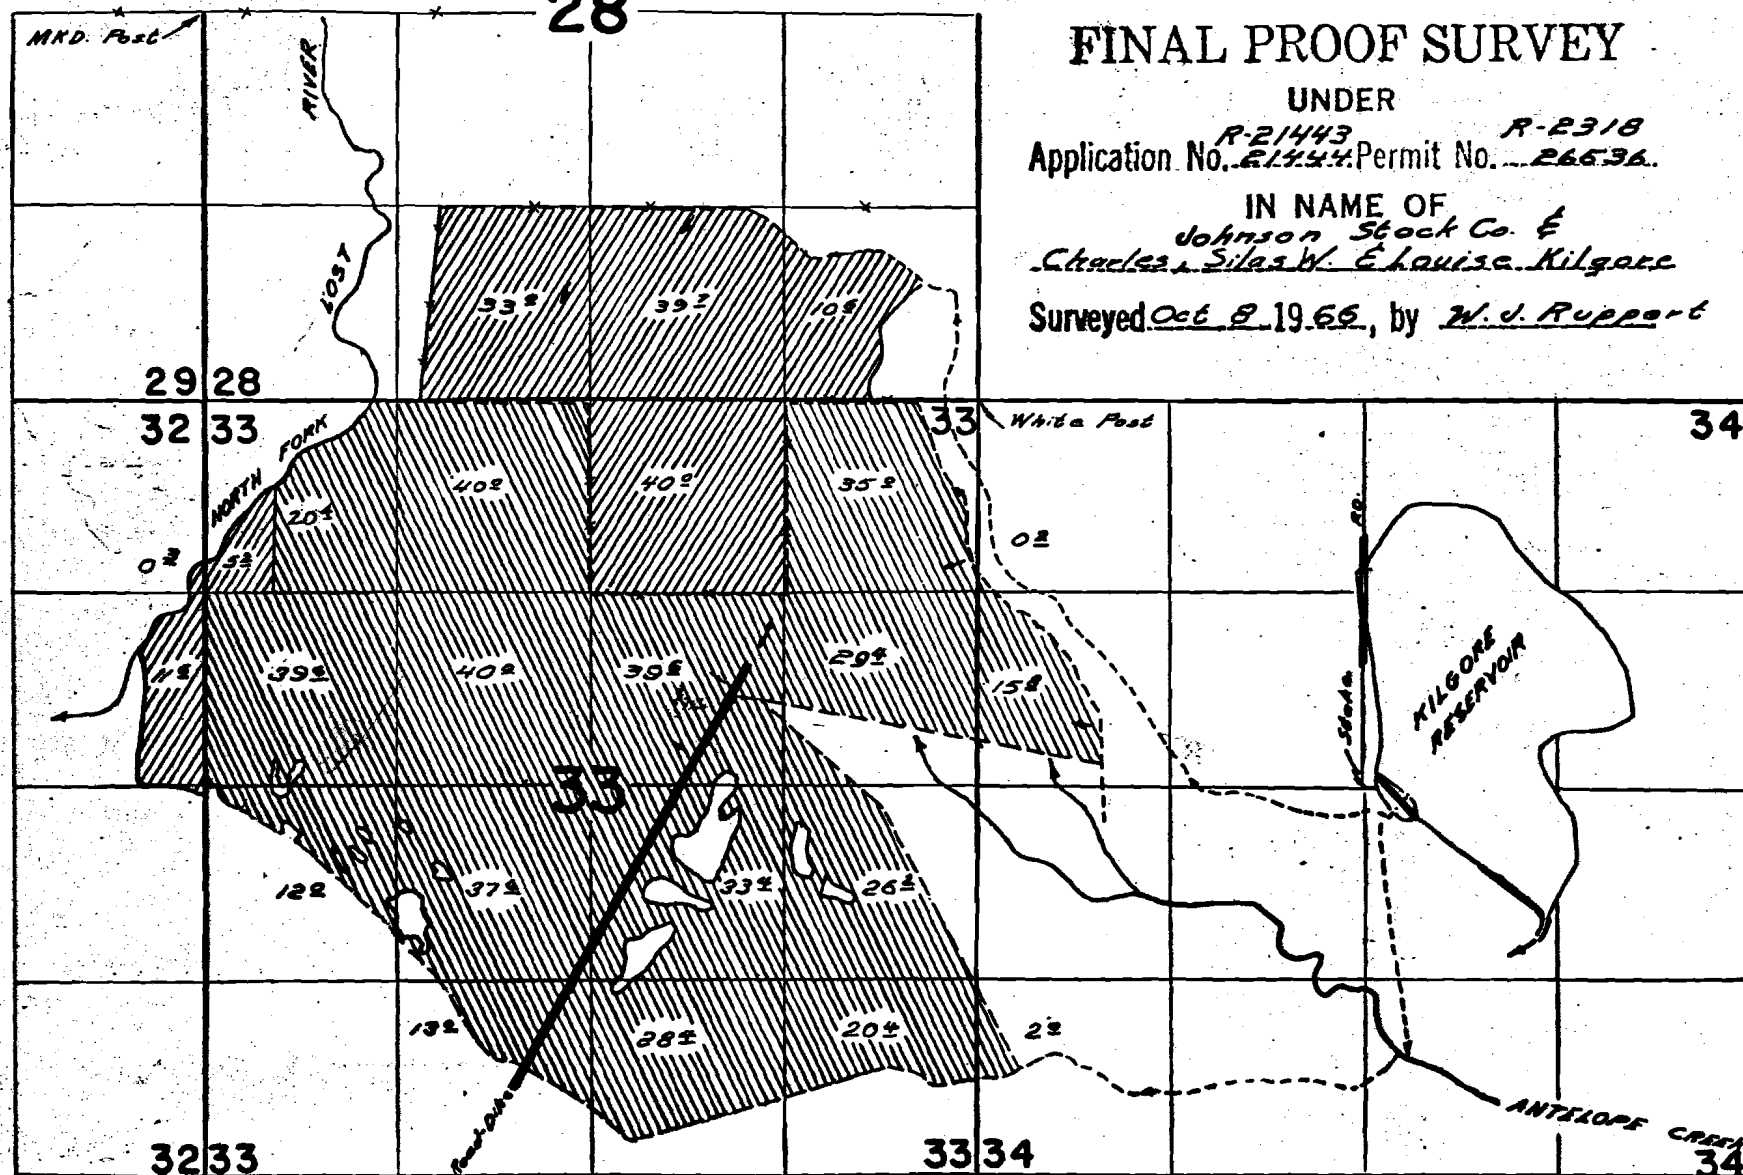

Primary  Supplemental

Dir. Pt. located 130 ft. S. & 230 ft. E.
from Center Sta. 34.

39248