


30749
38249

T.37S.R.11E.W.M.

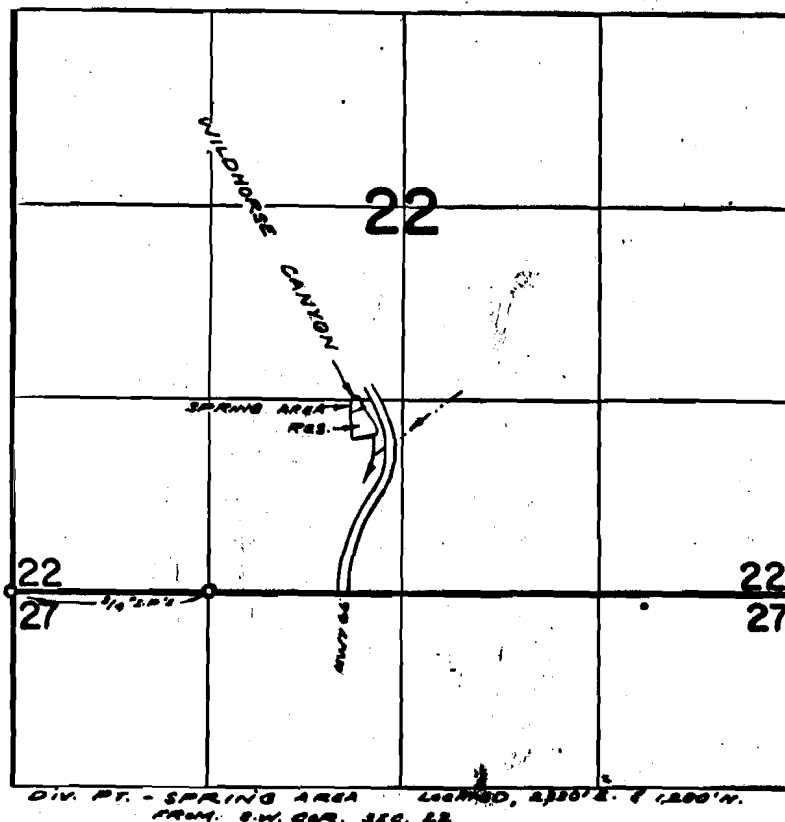

FINAL PROOF SURVEY
UNDER

40952 30749
Application No. ~~R-4442~~ Permit No. ~~R-4442~~
IN NAME OF

KLAMATH FALLS FOREST ESTATES, UNIT II

Surveyed *MAY 13*, 1970, by *R. MUCKEN*