


R-4642
38250

T.37S.R.11E.W.M.

Buck Creek: Yonka Valley

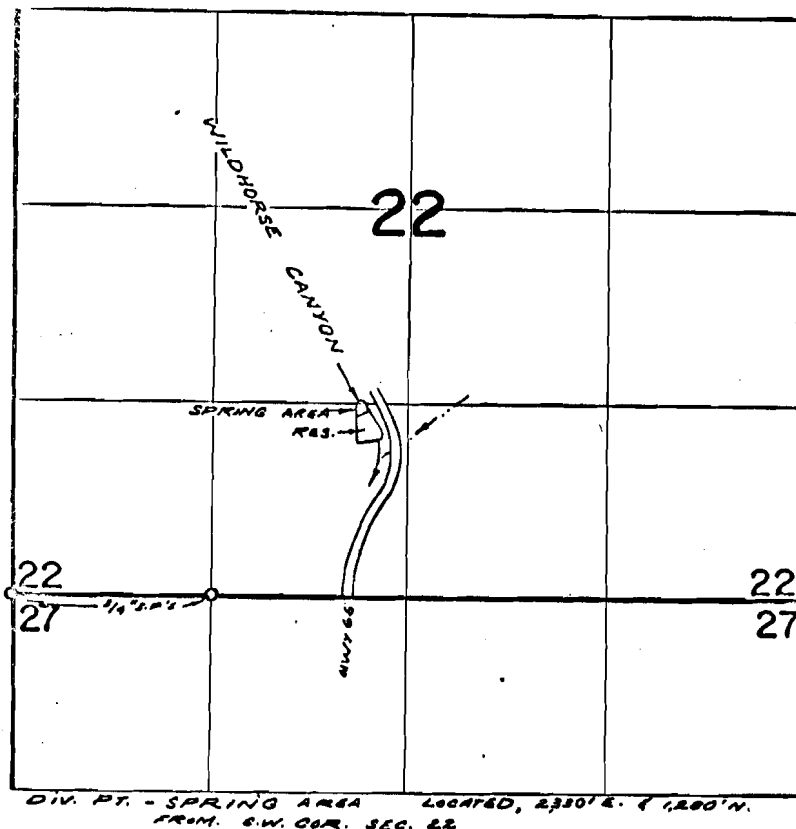

FINAL PROOF SURVEY
UNDER

Application No. ⁴⁰⁹⁵² ~~R-41263~~ Permit No. ³⁰⁷⁴⁹ ~~R-4642~~
IN NAME OF

KLAMATH FALLS FOREST ESTATES, UNIT II

Surveyed MAY. 13, 1970, by R. MUCKEN.