
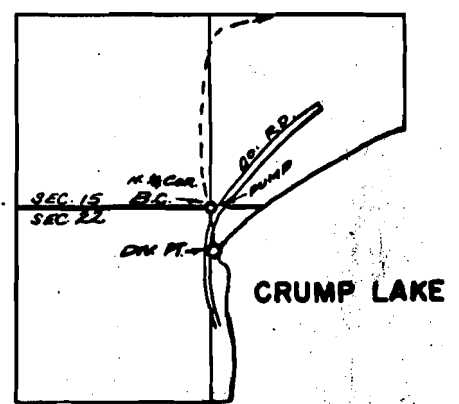


33332 13
38251

T.38S.R.24E.W.M.

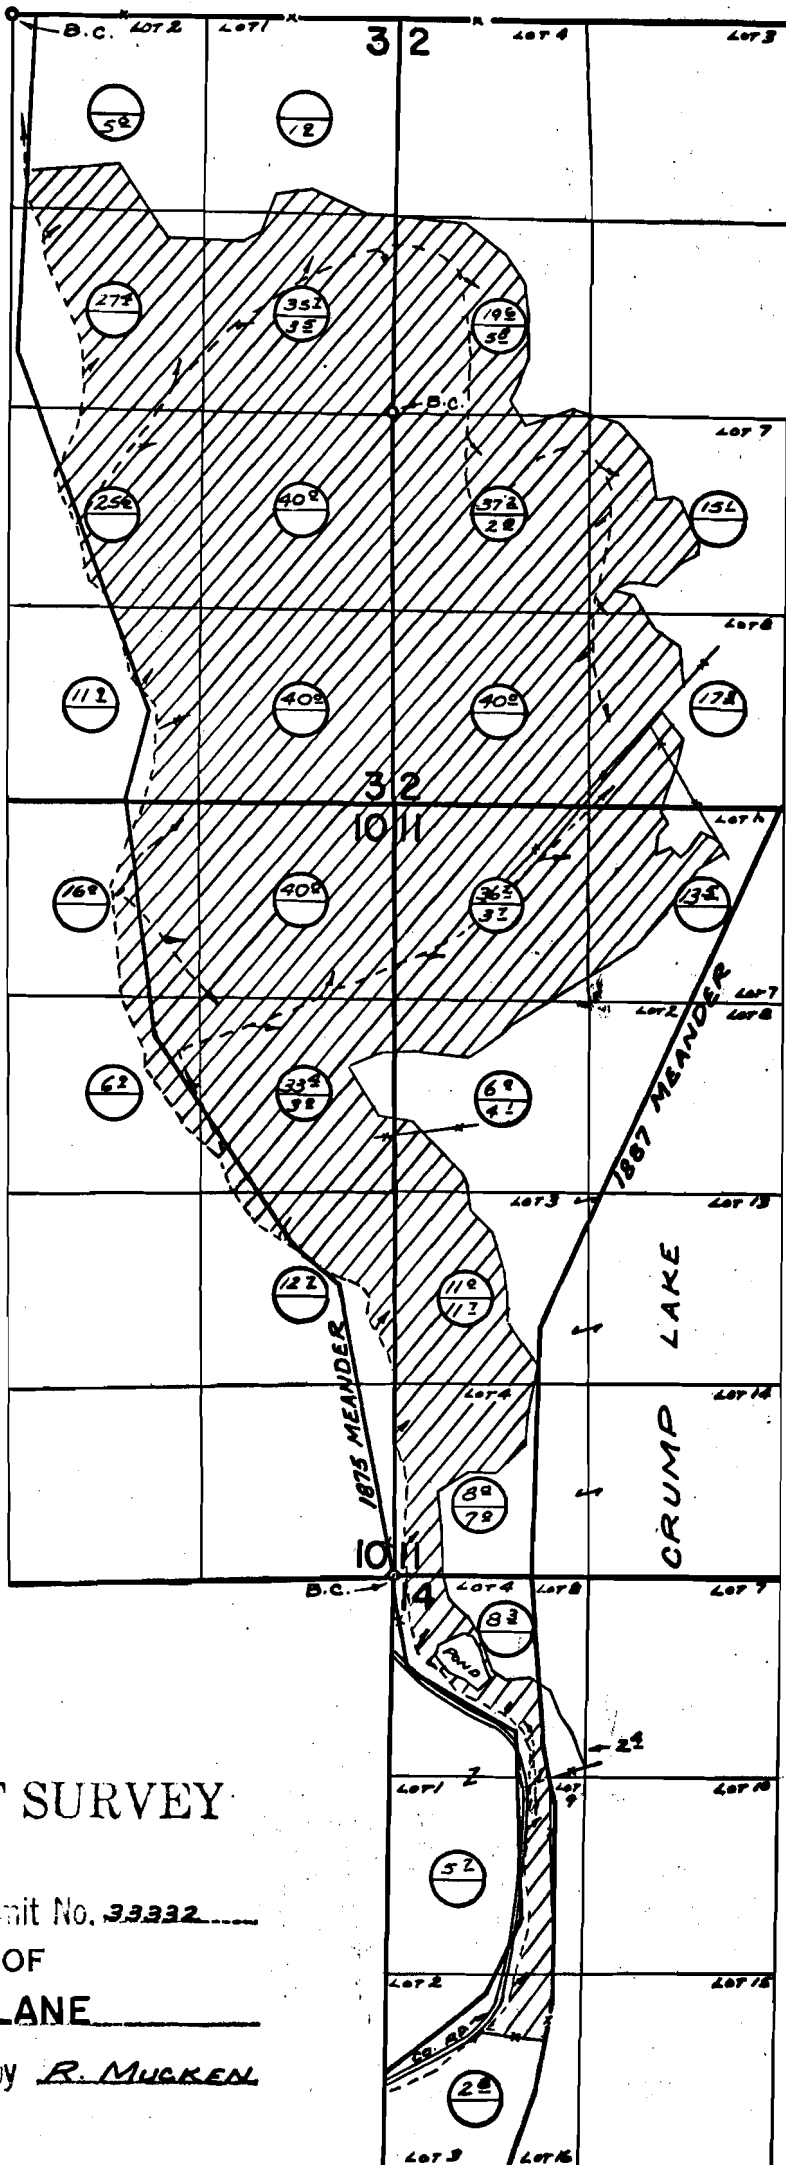

Div. of P. & L. 1881-290' S. of 30' E. from N. 1/4 Cor. Sec. 22

⊖ SUPPLEMENTAL TO GEAR 7441
PRIMARY

FINAL PROOF SURVEY
UNDER
Application No. 44953... Permit No. 33332
IN NAME OF
JOHN R. LANE
dated AUG. 12 1970, by R. MUCKEN