


T. 18 S. R. 5 W. W. M.

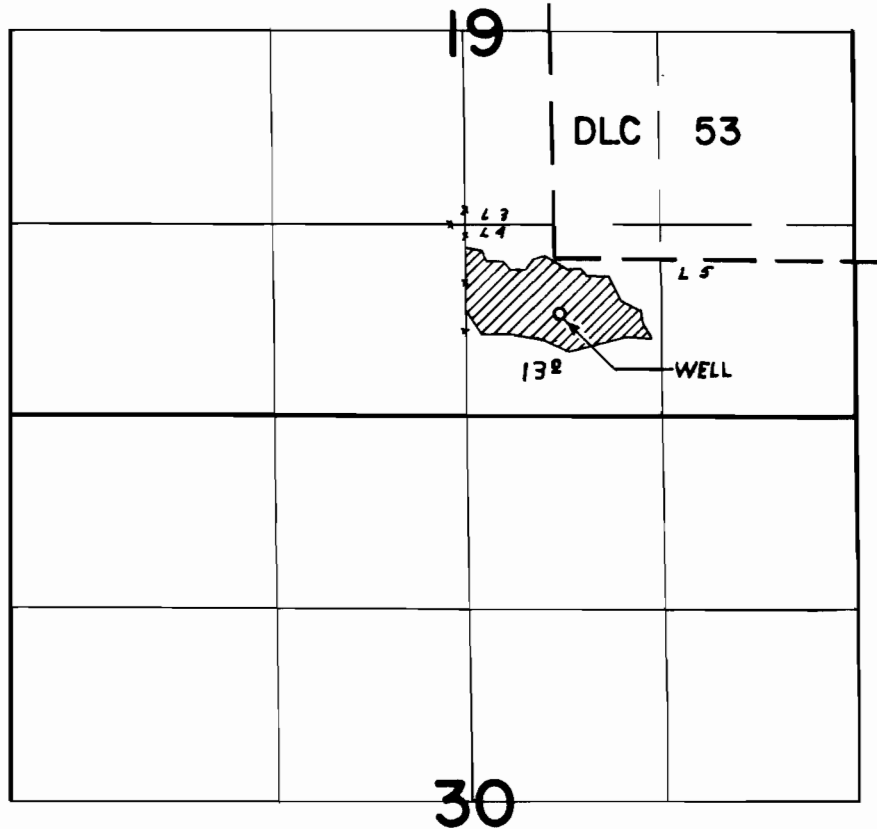

WELL LOC. 610' S & 640' E FROM NW COR SW 1/4 SE 1/4 SEC. 19

FINAL PROOF SURVEY
UNDER

Application No. G-3105 Permit No. G-2898.
IN NAME OF

.....ROBERT T. GEDEON.....

Surveyed AUG. 18. 1971., by R. MUCKEN.....