


T.17S.R.4W.W.M.

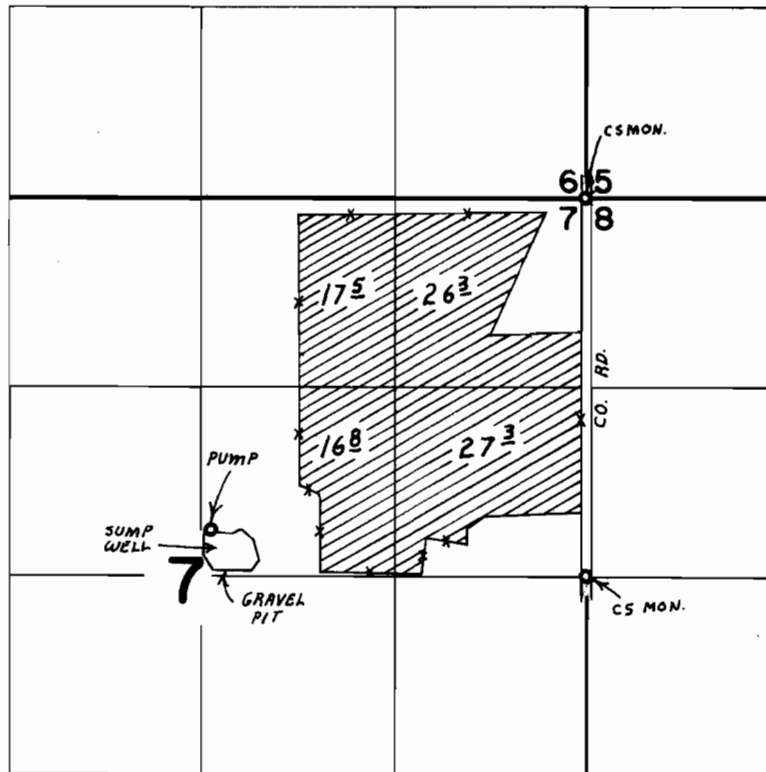

WELL LOC. 180' N. & 2460' W. FROM E 1/4 COR. SEC. 7

FINAL PROOF SURVEY

ORDER

Approved by G-3824 and G-3605

C.W. KOKKELER & THEA KOKKELER

WITNESSED OCT. 16 1970 BY G. BACA