


T. 15 S. R. 4 & 5 W. W. M.

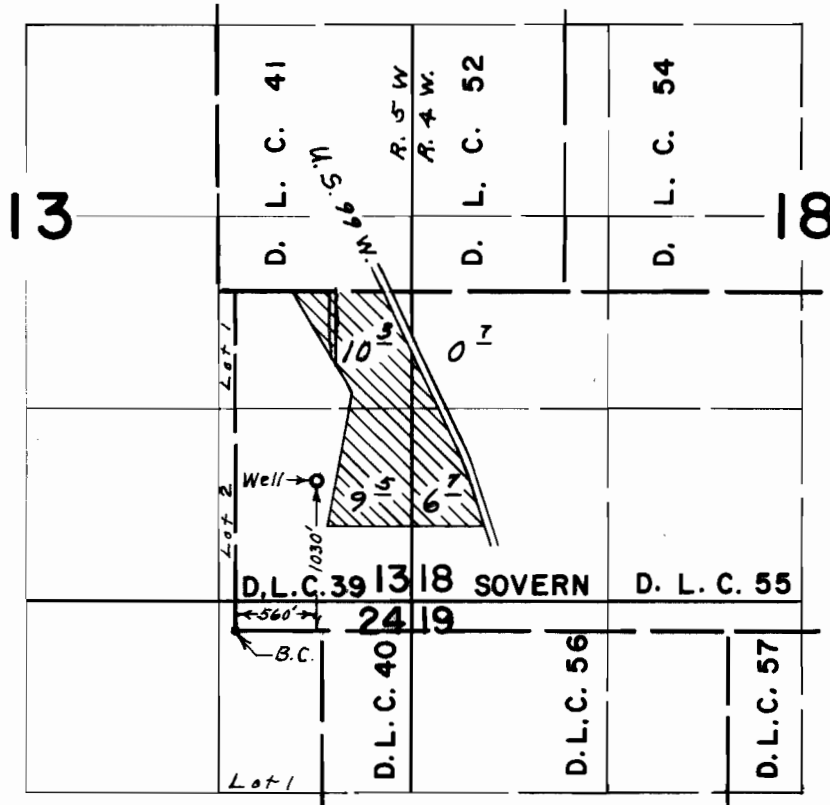

FINAL PROOF SURVEY UNDER

Application No. G-3926 Permit No. G-3686
IN NAME OF

ALFRED & NINA NIELSON

Surveyed Aug. 26, 1970, by L. E. Gould.