


T. 15 S. R. 4 W. W. M.

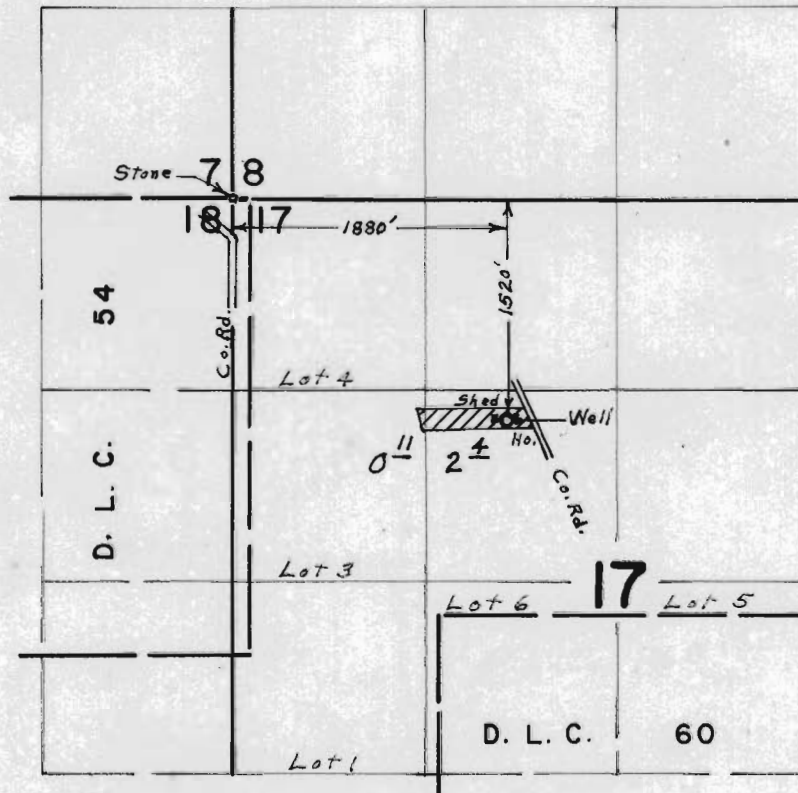

FINAL PROOF SURVEY

UNDER

Application No. G-4047 Permit No. G-3797

IN NAME OF

EUGENE & CLARA ROWDEN

Surveyed June 3, 1970, by L. E. Gould