


T.16 S.R.5 W.W.M.

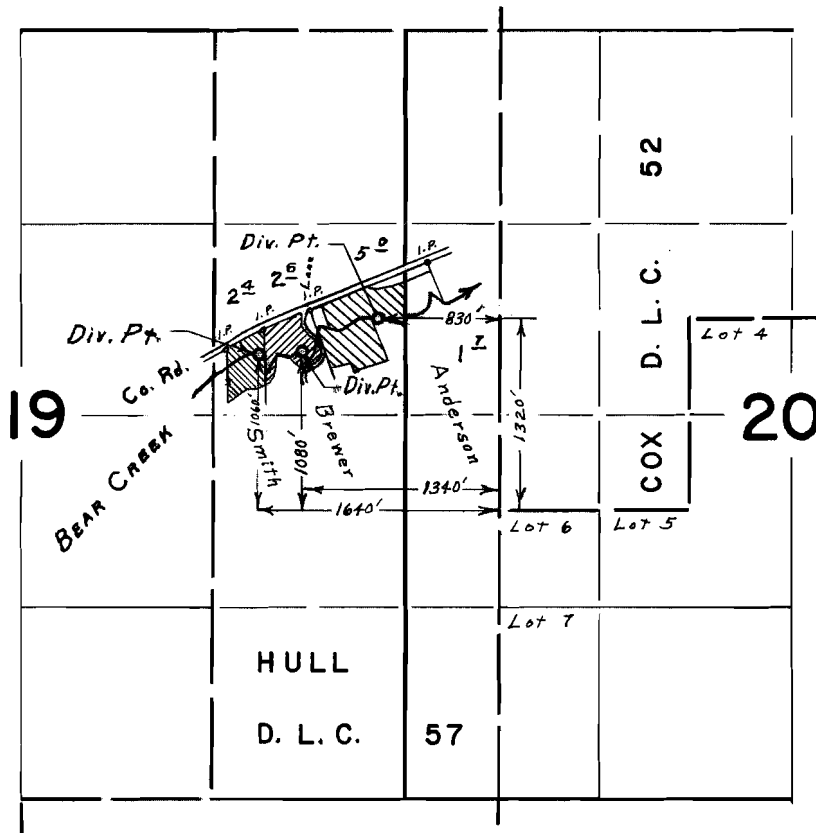

FINAL PROOF SURVEY
UNDER

Application No. 40254 Permit No. 30012
IN NAME OF
LELAND & CARMELITA ANDERSON
GORDON W. & DORIS M. BREWER
ORAN R. SMITH

Surveyed April 15, 1969, by L. E. Gould
Jan. 27, 1971, by G. McGinnis