


T.17S.R.1W.W.M.

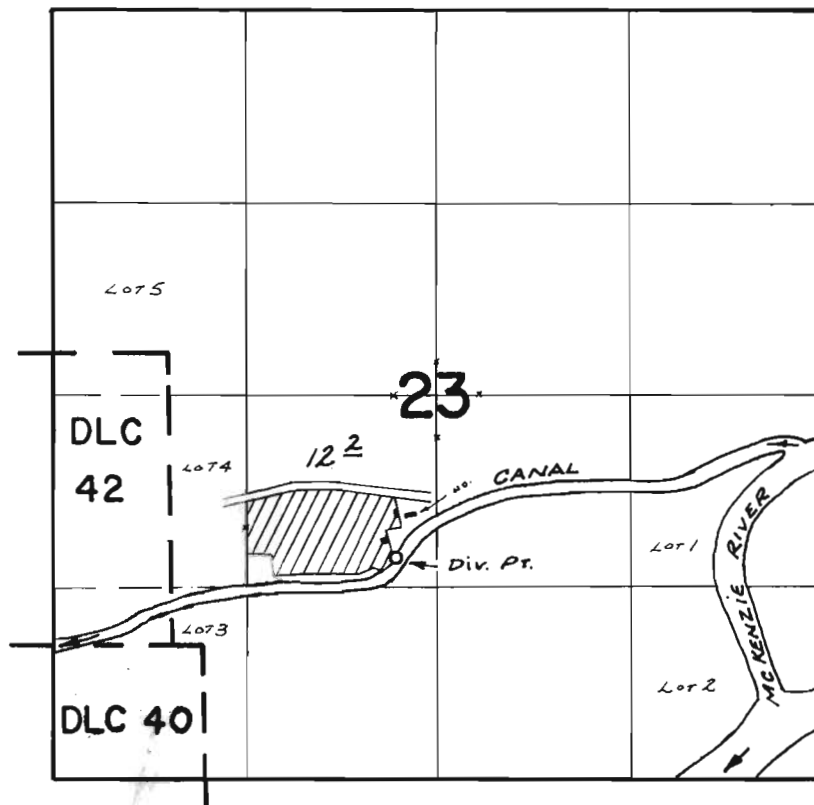

Re-Div. Pt. Loc: 1120' S. & 280' W. FROM CEN. SEC. 23

FINAL PROOF SURVEY

UNDER

Application No. 42214 Permit No. 31572

IN NAME OF

JAMES E. WEARIN

Surveyed OCT. 14, 1970, by R. MUCKEN