


T.18S.R.6W.W.M.

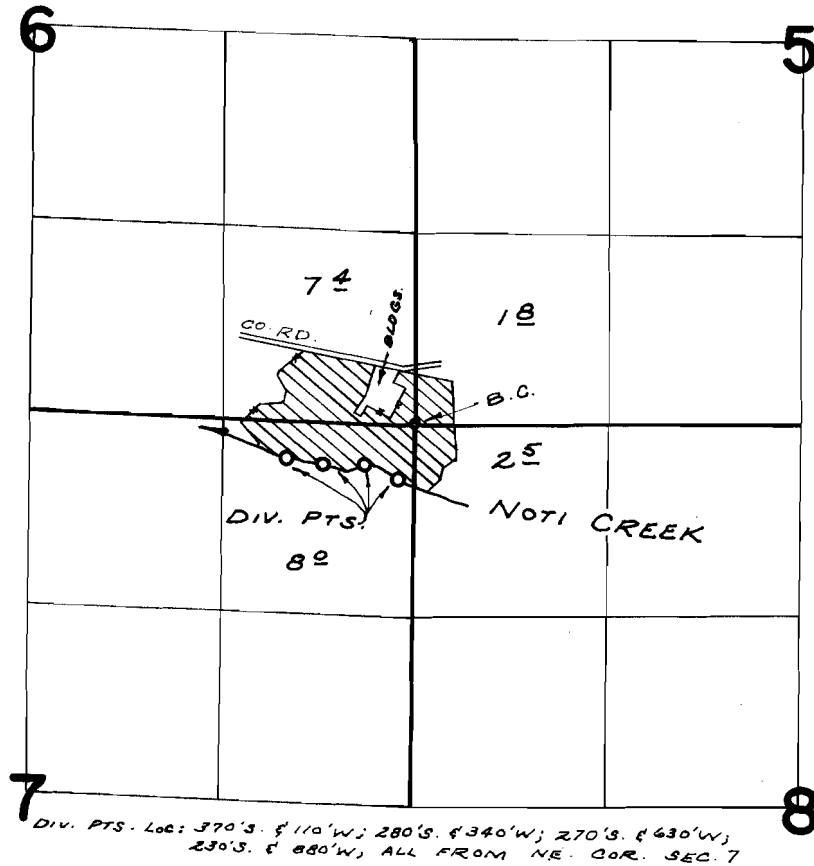

FINAL PROOF SURVEY
UNDER

Application No. 44167 Permit No. 32795
IN NAME OF _____

THOMAS JOHN & MARY E. HICKEY

Surveyed APR. 12, 1971, by R. MUCKEN