


T.16S.R.7W.W.M.

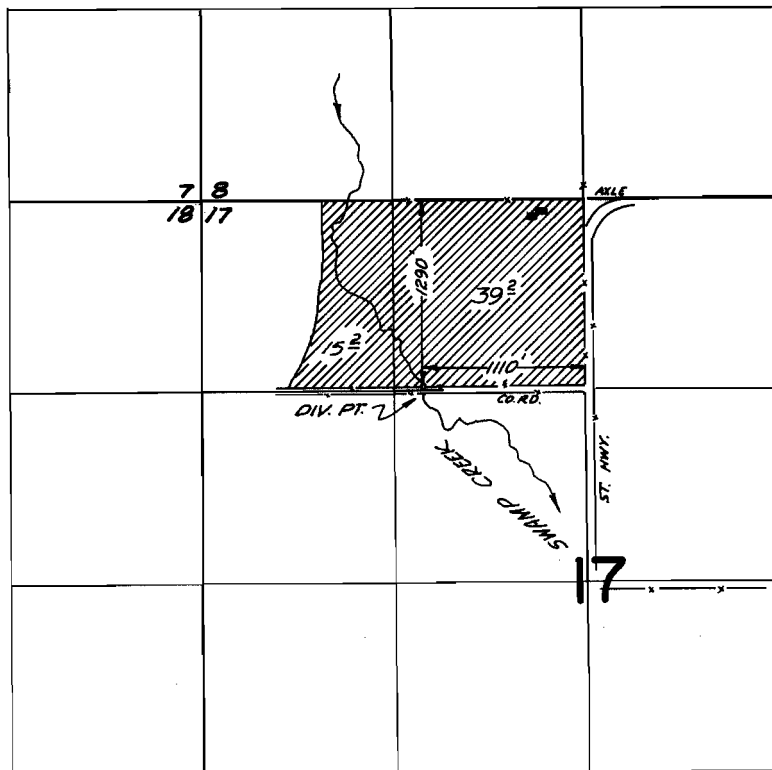

FINAL PROOF SURVEY

UNDER

Application No. 44523 Permit No. 333/5
IN NAME OF

JEAN CACAN

Surveyed March 23 1970, by V.R. Garner