


T. 6 S. R. 2 W. W. M.

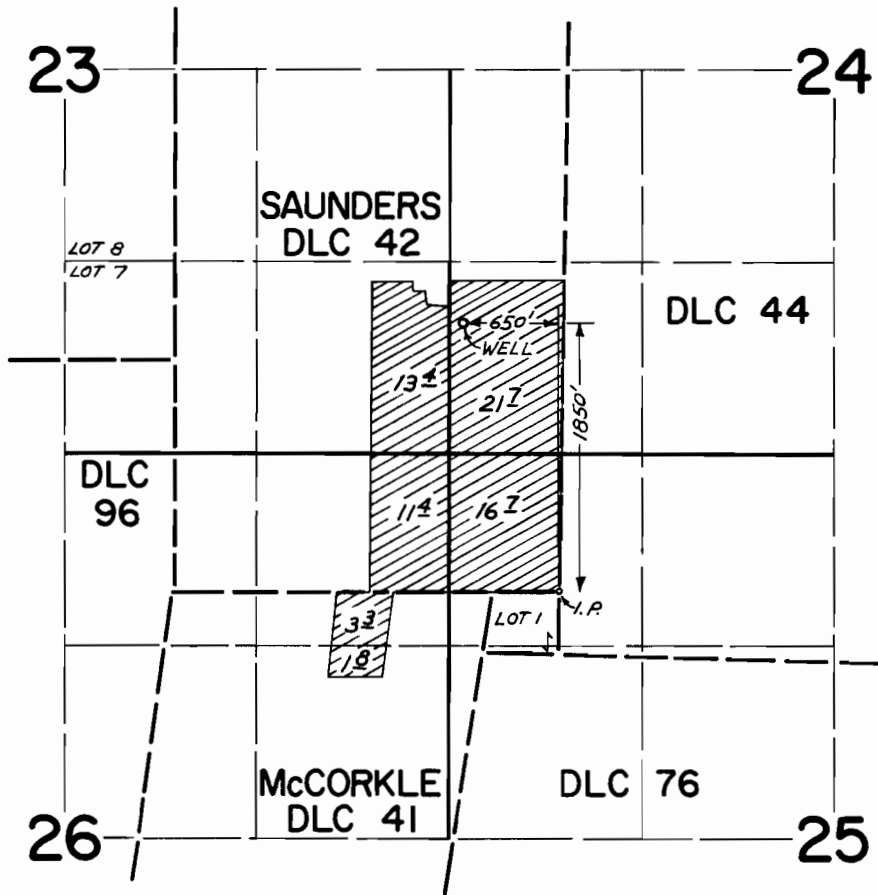

FINAL PROOF SURVEY
UNDER

Application No. G-3230 Permit No. G-3037
IN NAME OF

H. C. ESPE

Surveyed JUNE 4, 1971, by GREG BACA