


T. 6 S. R. 2 W. W. M.

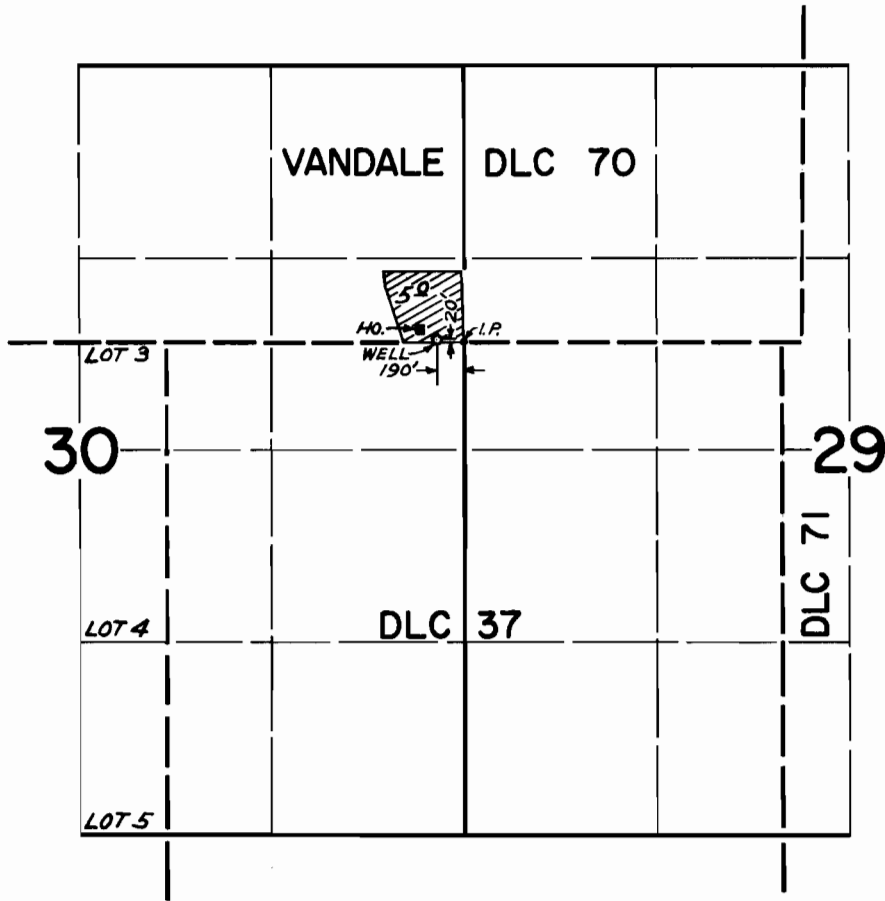

FINAL PROOF SURVEY
UNDER

Application No. G-3512 Permit No. G-3306
IN NAME OF

ROBERT F. RAMSEY

Surveyed JUNE 4 1971, by GREG BACA