


T. 4 S. R. 1 W. W. M.

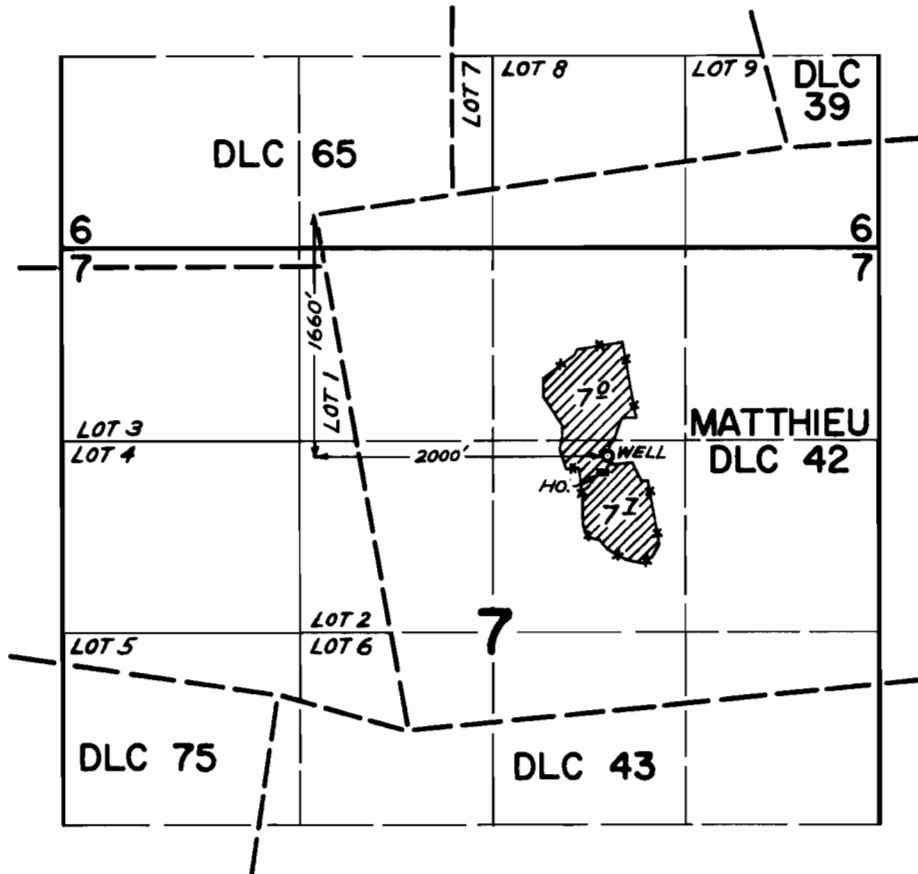

FINAL PROOF SURVEY
UNDER

Application No. G-3733 Permit No. G-3527
IN NAME OF

FRANCES M. CASHMAN

Surveyed JULY 14, 1971, by GREG BACA