


T. 6 S. R. 2 W. W. M.

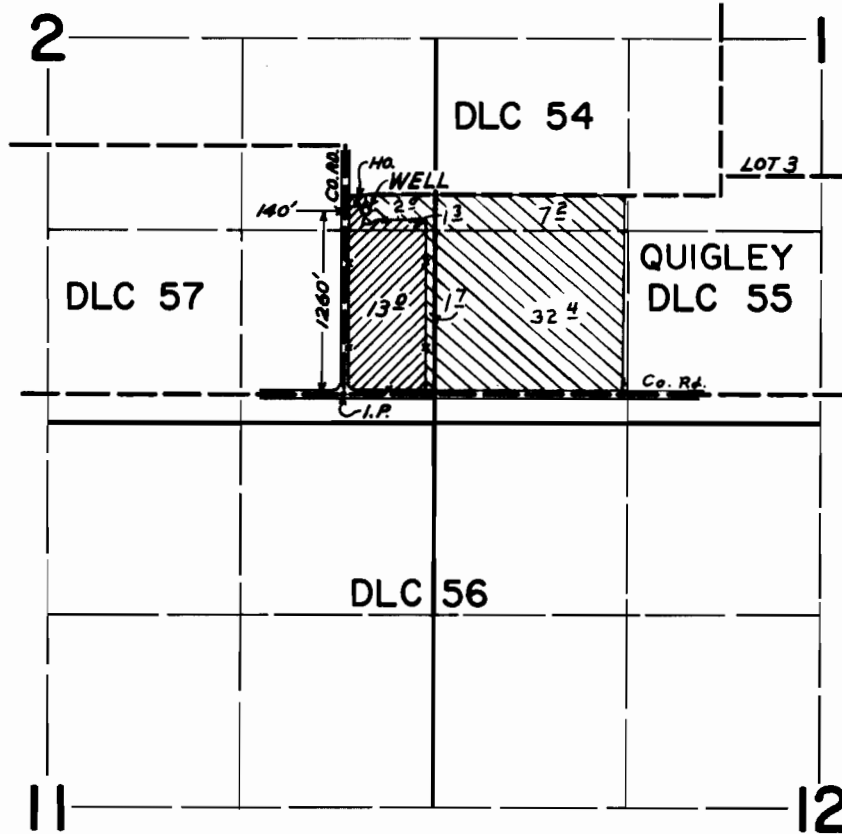

FINAL PROOF SURVEY
UNDER

G-7246 G-6650
Application No. ~~G-3892~~ Permit No. ~~G-3658~~
IN NAME OF



..... JOSEPH ZELLNER

Surveyed JULY 30 1971, by GREG BACA
APR 25 1979 L. H. NUNN