


T. 4 S. R. 2 W. W. M.

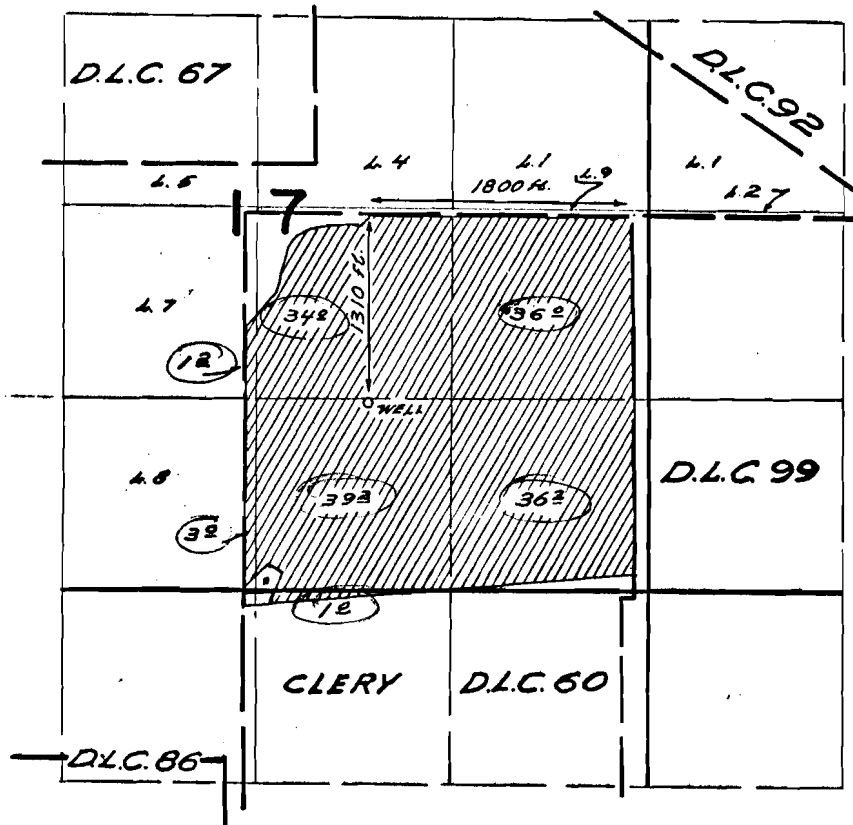

(X) Allowed on Cert. 35669
A-G 3024
P-2813

FINAL PROOF SURVEY
UNDER

Application No. G-3024 Permit No. G-2813
IN NAME OF

WALTER J. WILMES

Surveyed May 2, 1967, by W. J. Ruppert