


T. 6 S. R. 2 W. W. M.

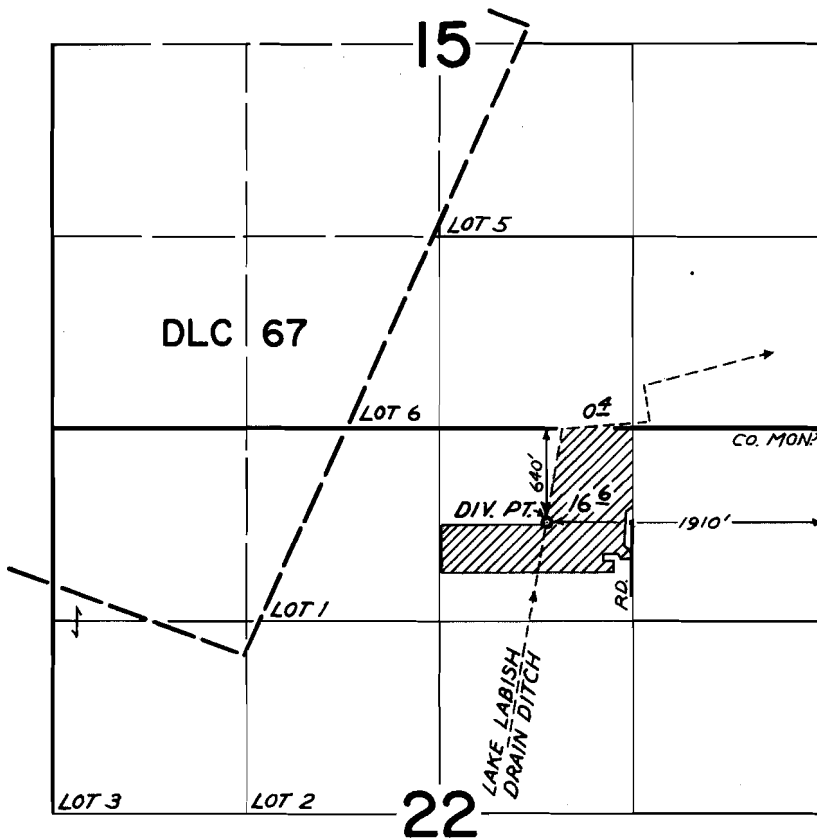

FINAL PROOF SURVEY UNDER

Application No. 438/2 Permit No. 32755
IN NAME OF

HARRY LOVRE

Surveyed JULY 27 1971, by GREG BACA