


G-4197
(See 33465)
38271

T.I.S.R.24E.W.M.

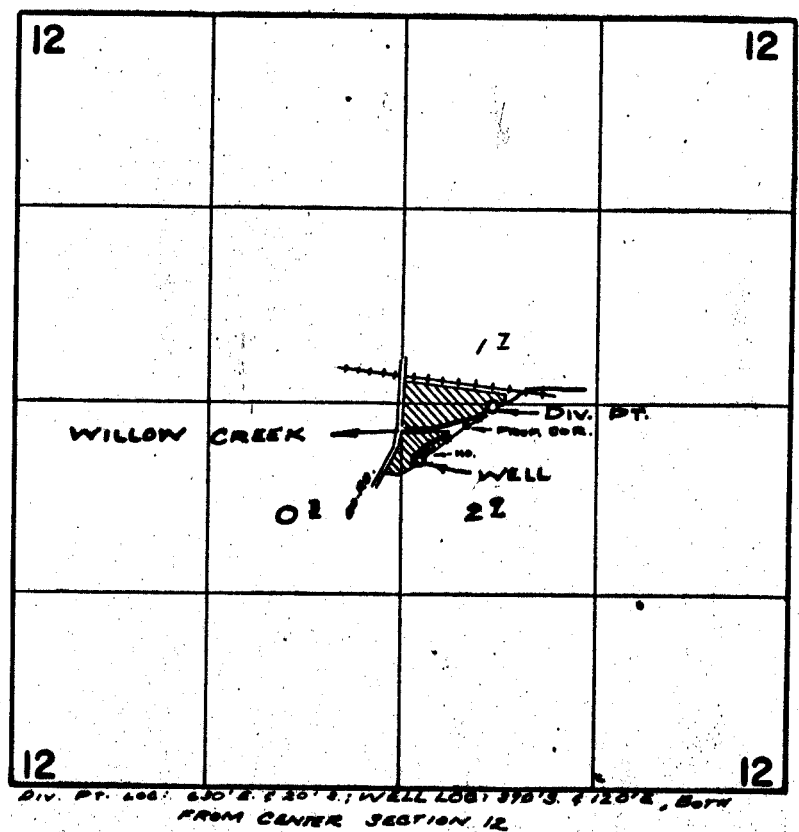

FINAL PROOF SURVEY UNDER

Application No. ~~44697~~ ^{G-4453} Permit No. ~~33465~~ ^{G-4197}
IN NAME OF

JOHN W. JEPSEN

Surveyed Max Z. 1971, by R. MUGGEN