


T. 2 S. R. 26 E. W. M.

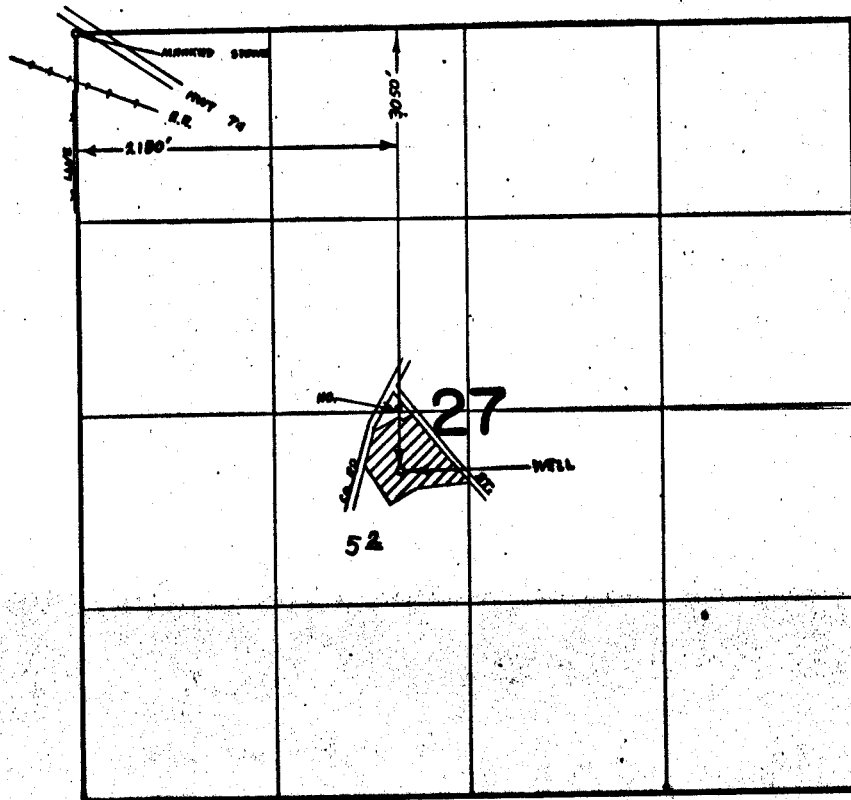

FINAL PROOF SURVEY UNDER

Application No. G-4600 Permit No. G-4324
IN NAME OF

J. E. LaTRACE

Surveyed MAY 4, 1971, by R. MUCKEN