


T.3&4S.R.16E.W.M.

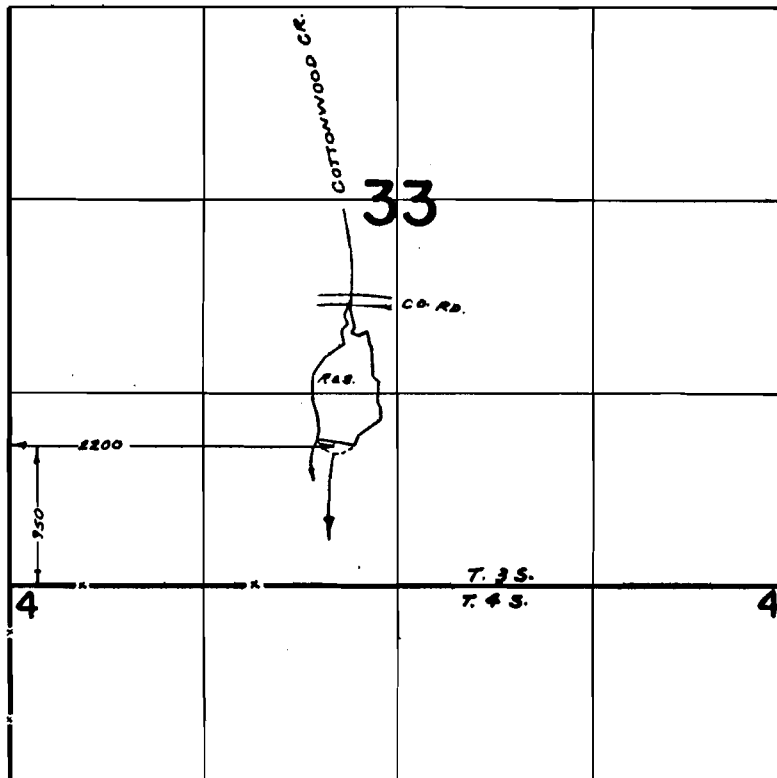

FINAL PROOF SURVEY

UNDER

Application No. ^{R-42194} 42195 Permit No. ^{R-4712} 31195

IN NAME OF

JOHN W. BUETHER

Surveyed OCT. 23 1970, by R. MUCKEN