


C38277

T.38&4S.R.16E.W.M.

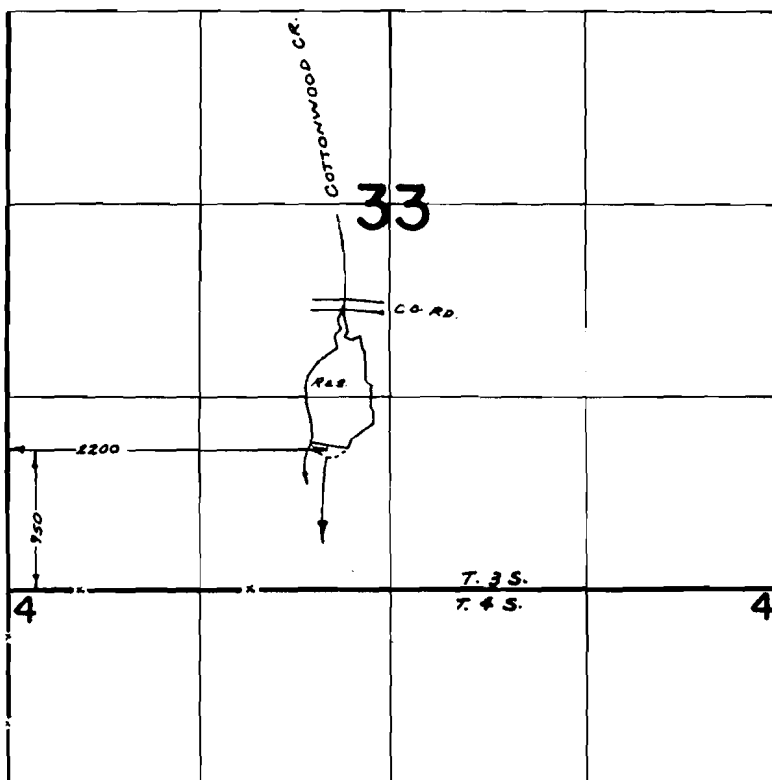

FINAL PROOF SURVEY

UNDER

Application No. R-42194 32195 Permit No. R-4712 31195

IN NAME OF

JOHN W. BUETHER

Surveyed OCT. 23 19 70, by R. MUCKEN