


T. 2 S. R. 9 W. W. M.

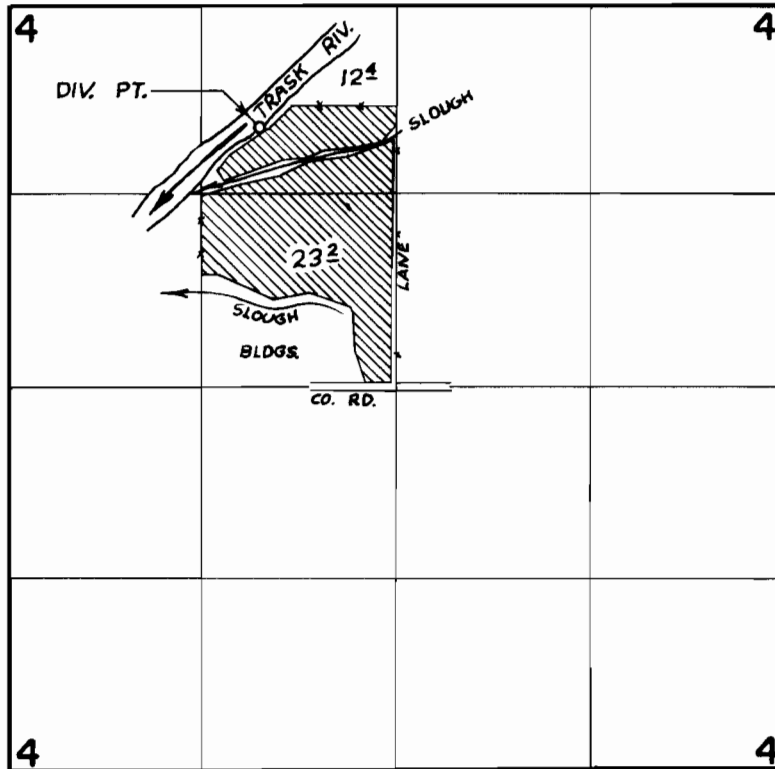

**FINAL PROOF SURVEY**  
UNDER

Application No. 37577.... Permit No. 27994....  
IN NAME OF

ESTATE OF JACK BARKER.....

Surveyed AUG. 6, 1971, by R. MUCKEN.....