


T. 3 N. R. 10 W. W. M.

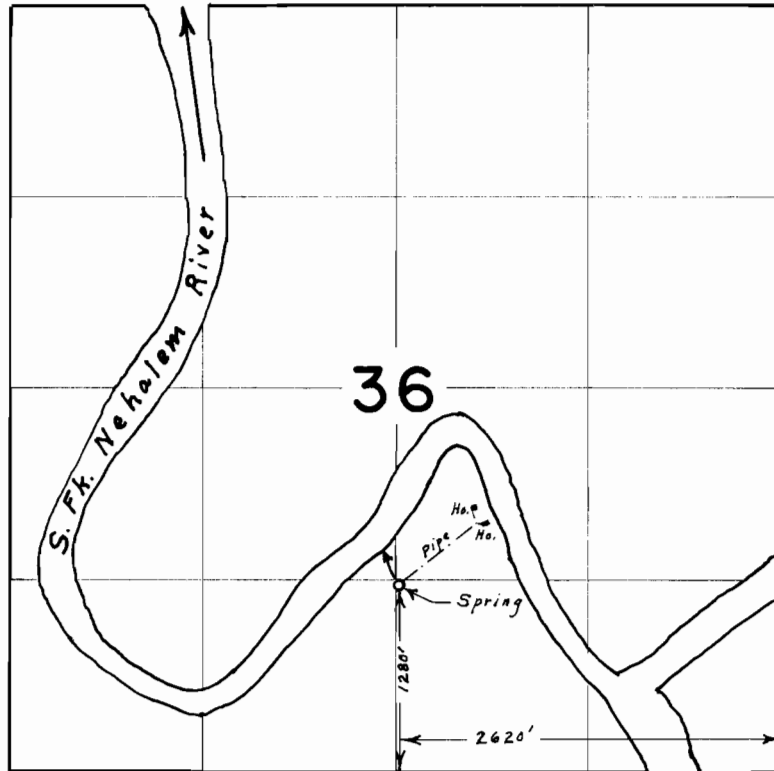

FINAL PROOF SURVEY
UNDER

Application No. 39338 Permit No. 29354
IN NAME OF

WILLIAM D. FRITZ

Surveyed June 9, 1971, by L. E. Gould