


T. 3 S. R. 9 W. W. M.

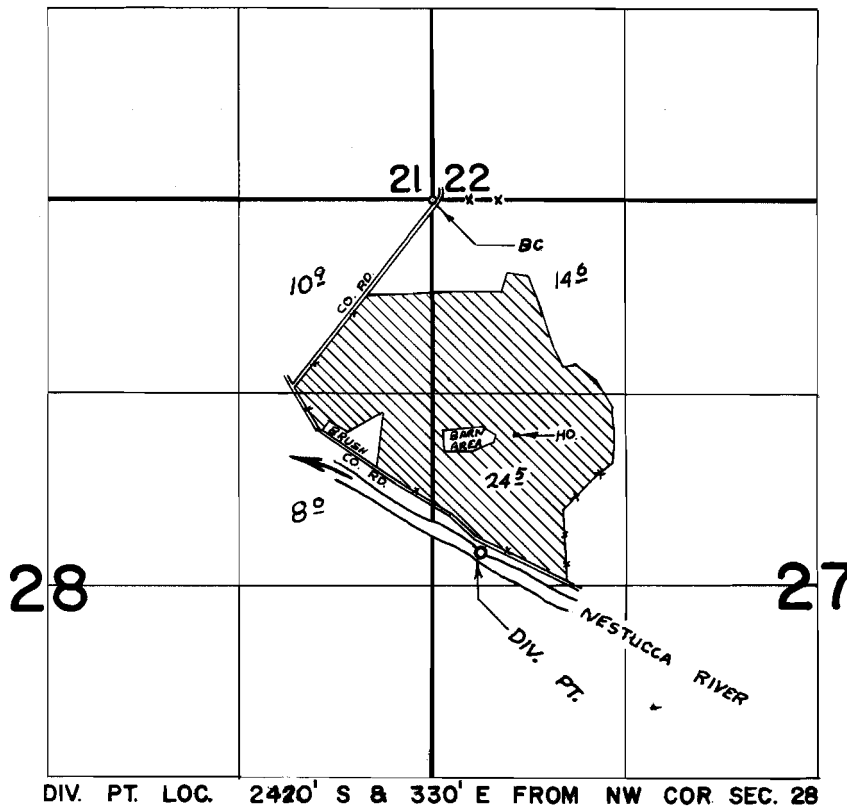

FINAL PROOF SURVEY UNDER

Application No. 39897... Permit No. 29697...
IN NAME OF

RAY K. & BETTY C. MEASOR

Surveyed AUG. 12, 1971, by R. MUCKEN