


T. 5 S. R. 9 W. W. M.

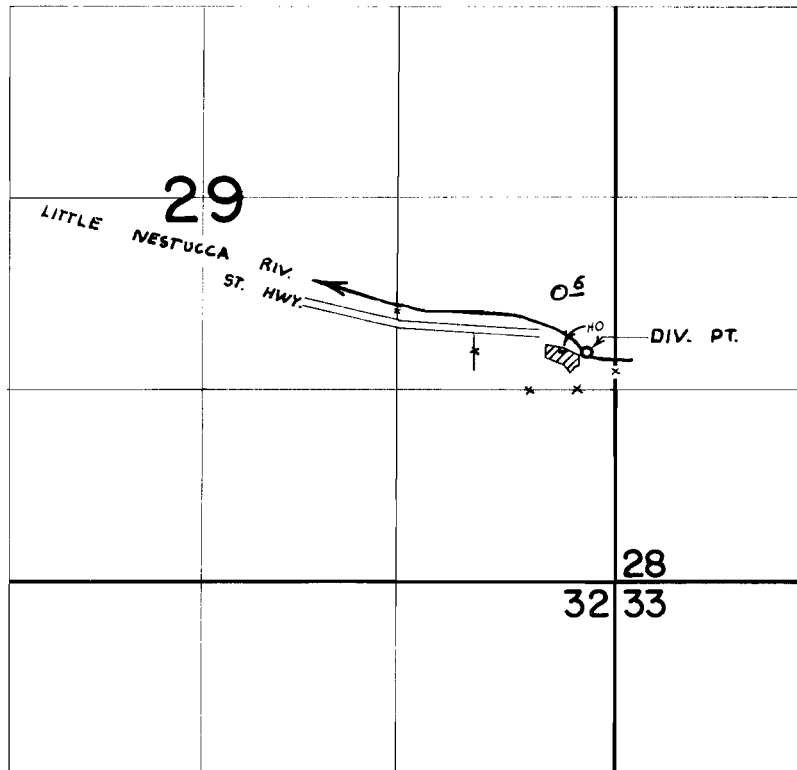

DIV. PT. LOC. 250' N & 190' W FROM SE COR. NE 1/4 SE 1/4 SEC. 29

FINAL PROOF SURVEY
UNDER

Application No. 41127... Permit No. 30661...
IN NAME OF

J. S. & IONE CRAWFORD

Surveyed AUG. 11, 1971, by R. MUCKEN