


T. 3 N. R. 10 W. W. M.

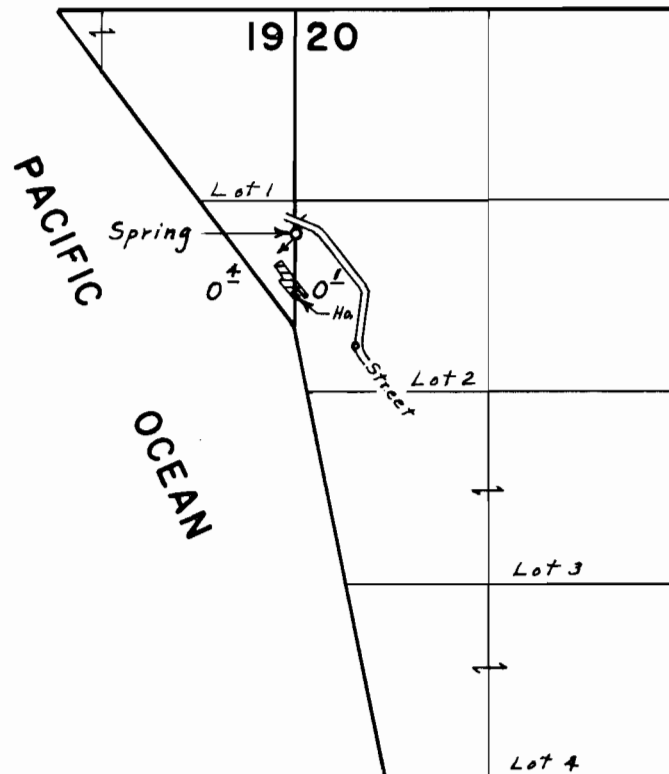

Spring located 1530' S. & 10' E. from N.W. Corner Section 20

FINAL PROOF SURVEY
UNDER

Application No. 41042... Permit No. 31270...
IN NAME OF

GEORGIA ALLEN

Surveyed June 8, 1971, by L. E. Gould.