


T. 3 N. R. 9 W. W. M.

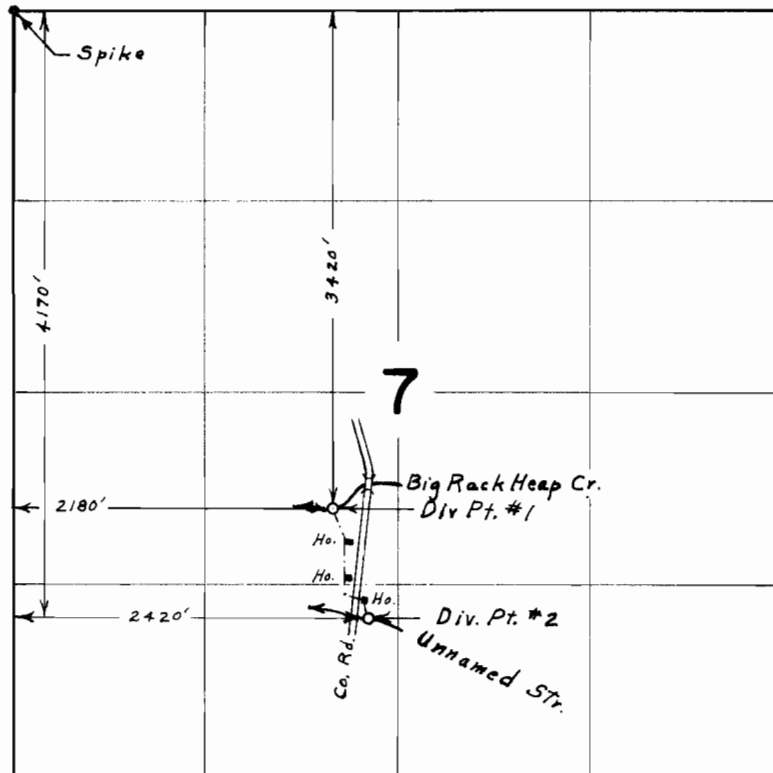

FINAL PROOF SURVEY
UNDER

Application No. 42845. Permit No. 32024..
IN NAME OF

ORVAL I. & JUNE PORTER

Surveyed June 8, 1971, by L. E. Gould.