


T. 3 S. R. 9 W. W.M.

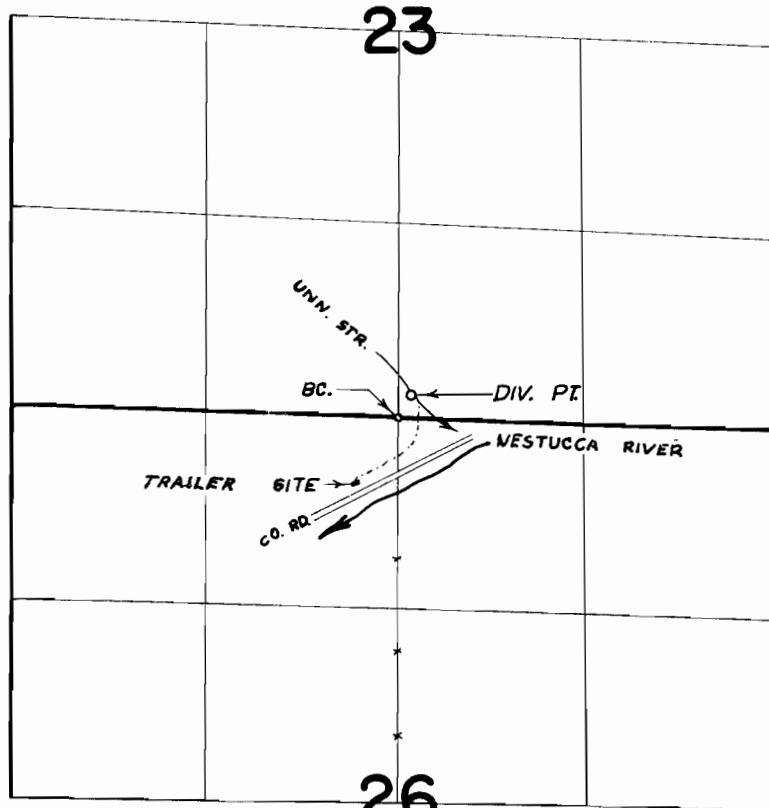

DIV. PT. LOC. 150' N & 90' E FROM S 1/4 COR. SEC. 23

FINAL PROOF SURVEY
UNDER

Application No. 43106... Permit No. 32213....
IN NAME OF

ROBERT & FAY B. BOLIN.....

Surveyed AUG. 13, 1971., by R. MUCKEN.....