


T. 3 N. R. 10 W. W.M.

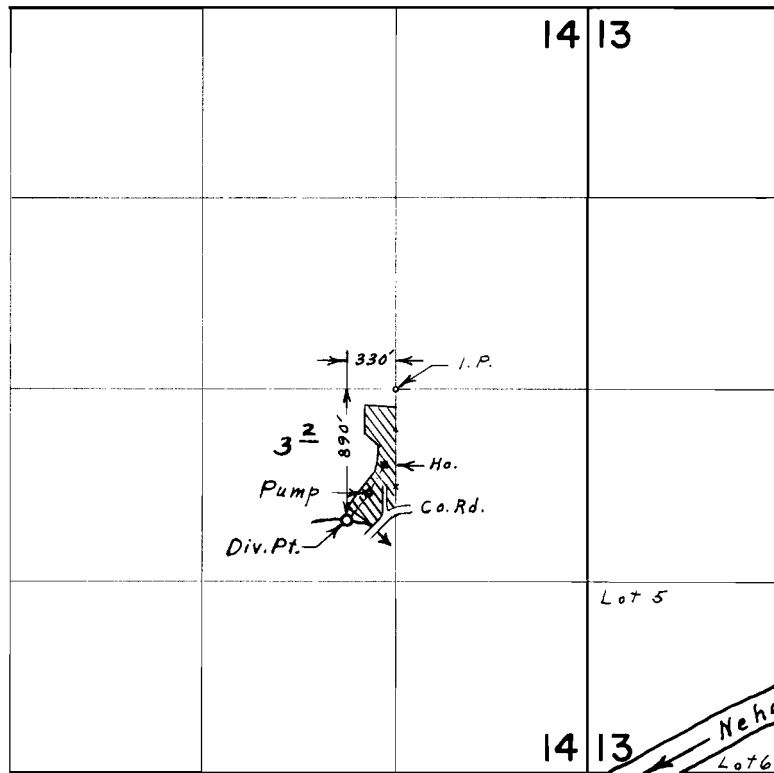

FINAL PROOF SURVEY
UNDER

Application No. 43191 Permit No. 32290
IN NAME OF

CHARLES W. & SONDR A J. PALMER

Surveyed June 8, 1971, by L. E. Gould