


T I S. R. 9 W. W. M.

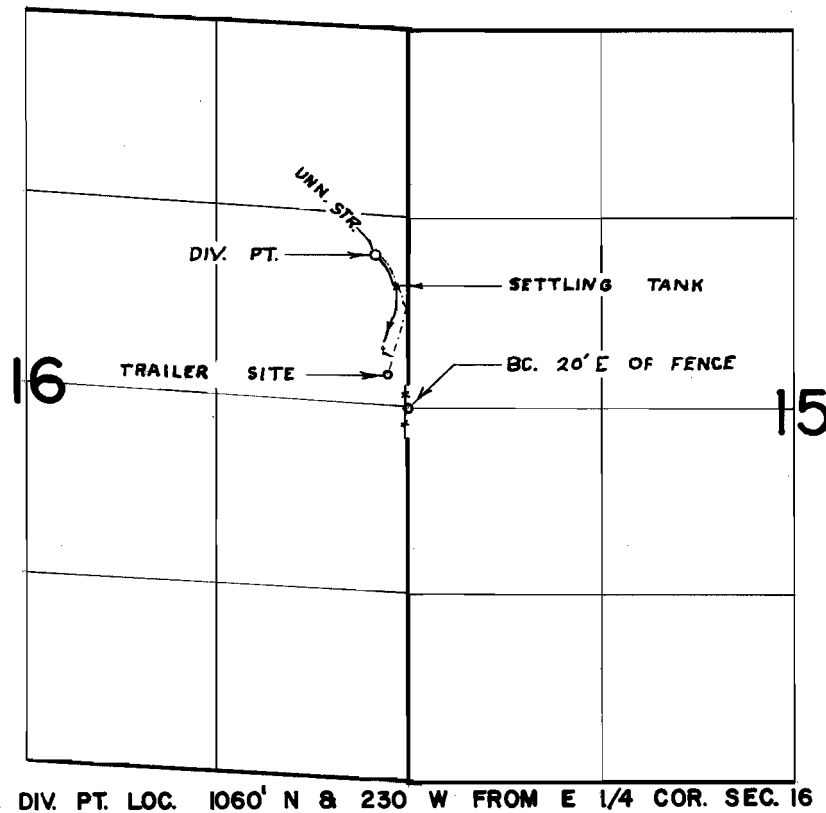

FINAL PROOF SURVEY
UNDER

Application No. 43474 Permit No. 32517
IN NAME OF

WARREN A. McMINIMEE

Surveyed AUG. 3. 1971, by R. MUCKEN