


T. 4 S. R. 10 W. W. M.

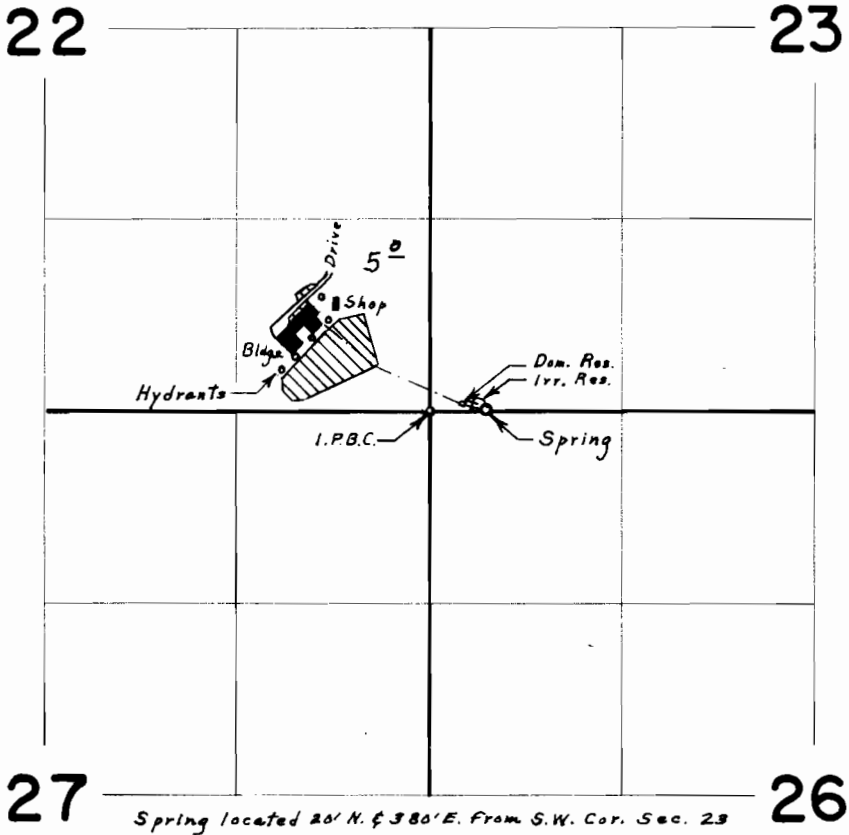

**FINAL PROOF SURVEY**  
UNDER

Application No. 45391 Permit No. 33890.

IN NAME OF  
**UNION HIGH SCHOOL NO. 3**  
TILLAMOOK COUNTY

Surveyed Aug. 12, 1971, by L. E. Gould.