


T. 4 N. R. 28 E. W. M. .

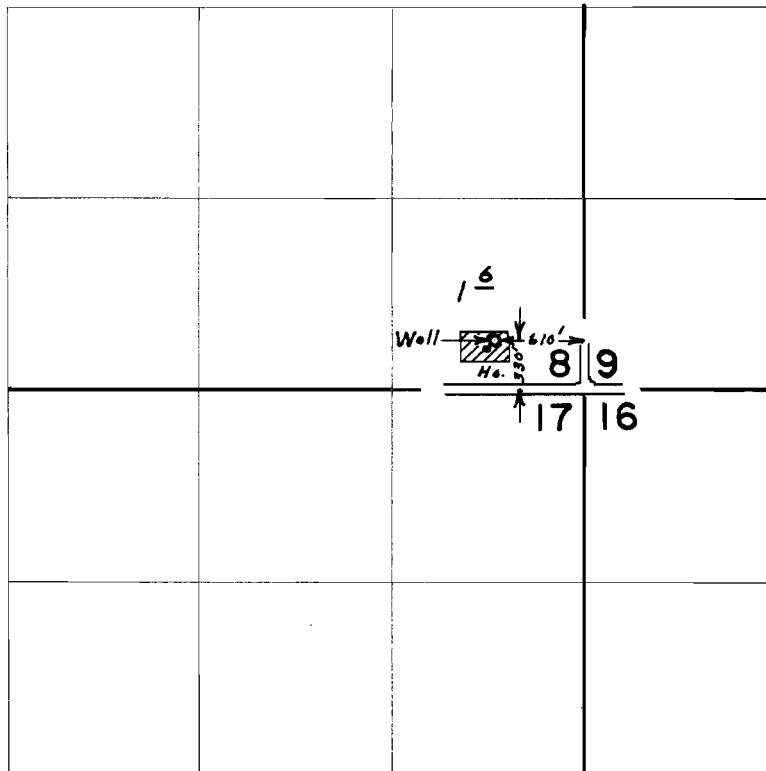

FINAL PROOF SURVEY
UNDER

Application No. G-4800 Permit No. G-4525
IN NAME OF

HAROLD L. ROSENBAUM

Surveyed June 22, 1971, by L. E. Gould