


T. 1 S. R. 3 W. W. M.

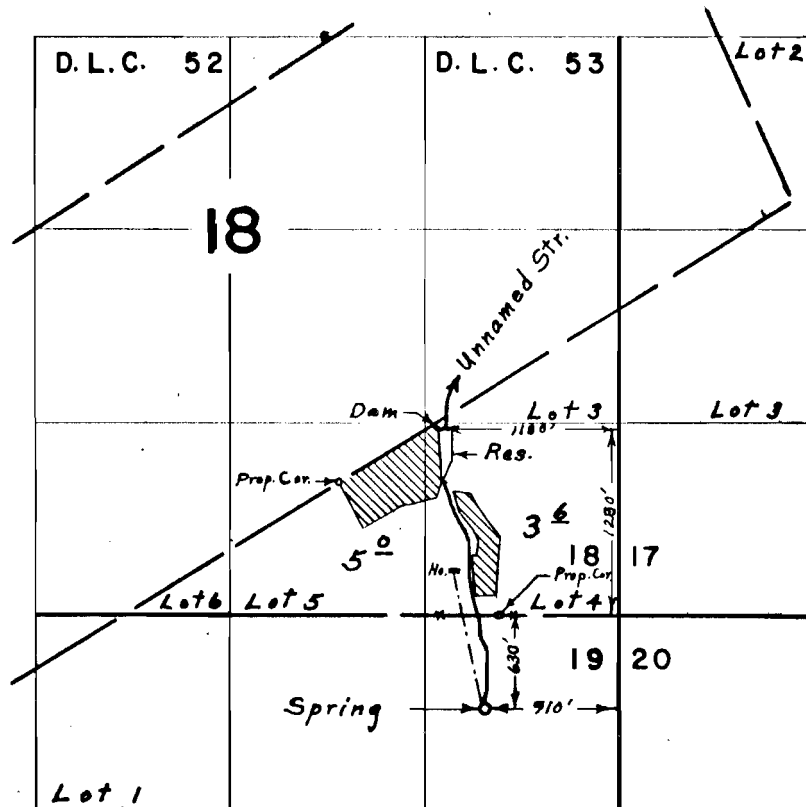

FINAL PROOF SURVEY UNDER

R-41094 R-4616
 Application No. 41095 Permit No. 30647
 IN NAME OF

ROBERT J. VANDE BERGH

Surveyed April 19, 1970, by L. E. Gould