


# T. 1 S. R. 3 W. W. M.

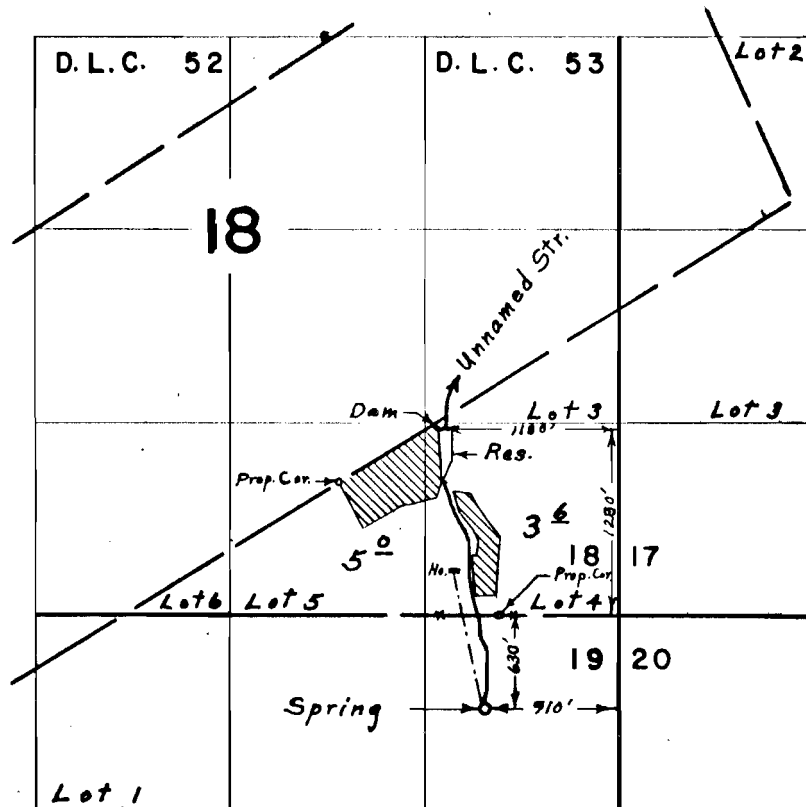

## FINAL PROOF SURVEY UNDER

R-41094                      R-4616  
 Application No. 41095    Permit No. 30647  
 IN NAME OF

**ROBERT J. VANDE BERGH**

Surveyed April 19, 1970, by L. E. Gould