


T. 2 S. R. 4 & 5 W. W. M.

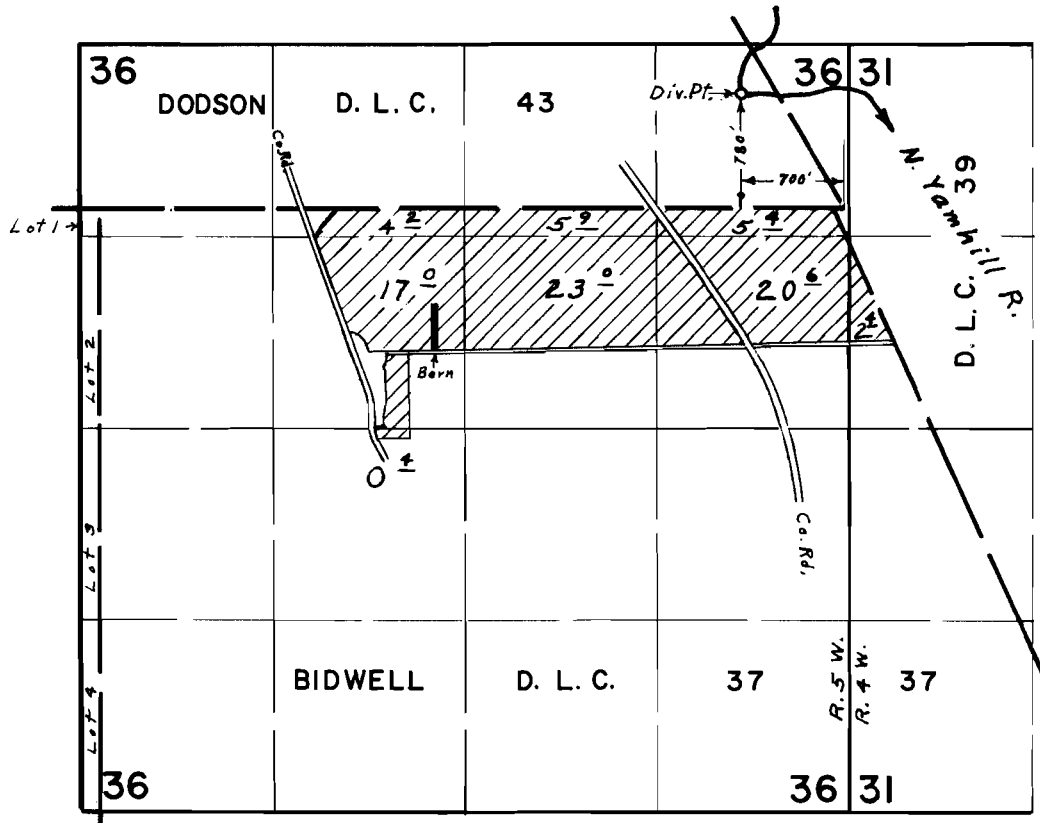

FINAL PROOF SURVEY UNDER

Application No. 45532 Permit No. 33975
IN NAME OF

GENE H. & JOYCE BELT

Surveyed April 30, 1971, by L. E. Gould