


T. 2 S. R. 4 & 5 W. W. M.

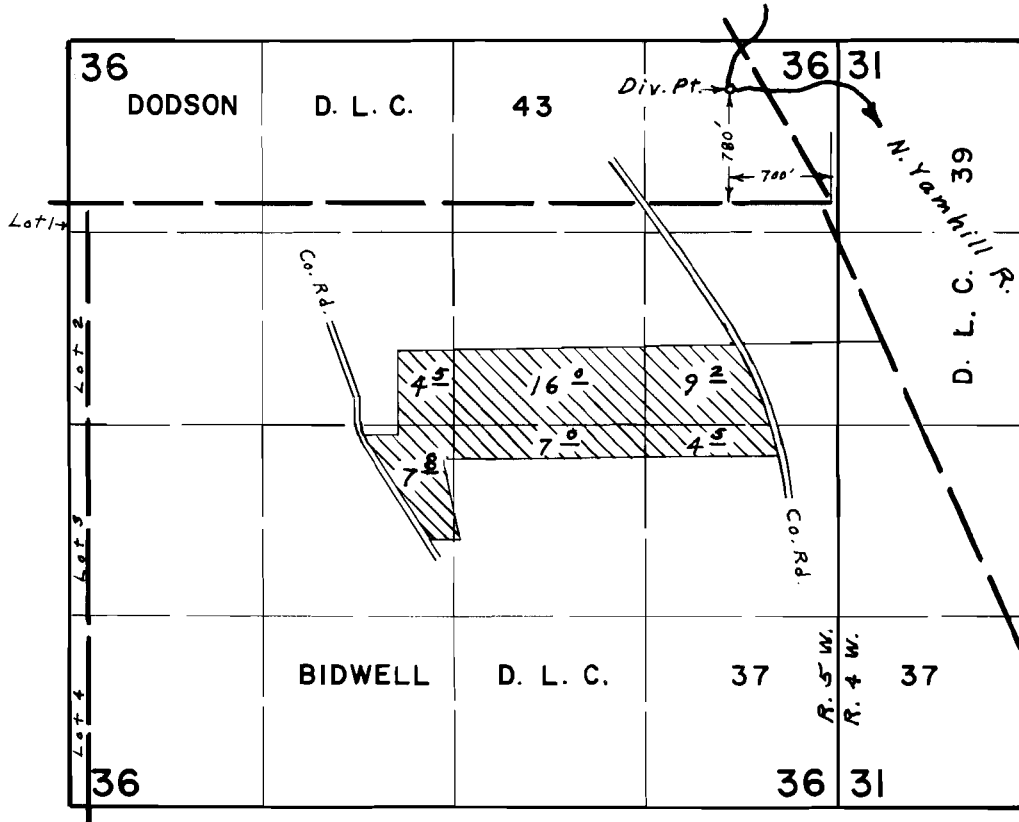

FINAL PROOF SURVEY UNDER

Application No. 45710 Permit No. 34097
IN NAME OF

GENE & JOYCE BELT

Surveyed April 30, 1971, by L. E. Gould