


# T. 2 S. R. 2 E. W. M.

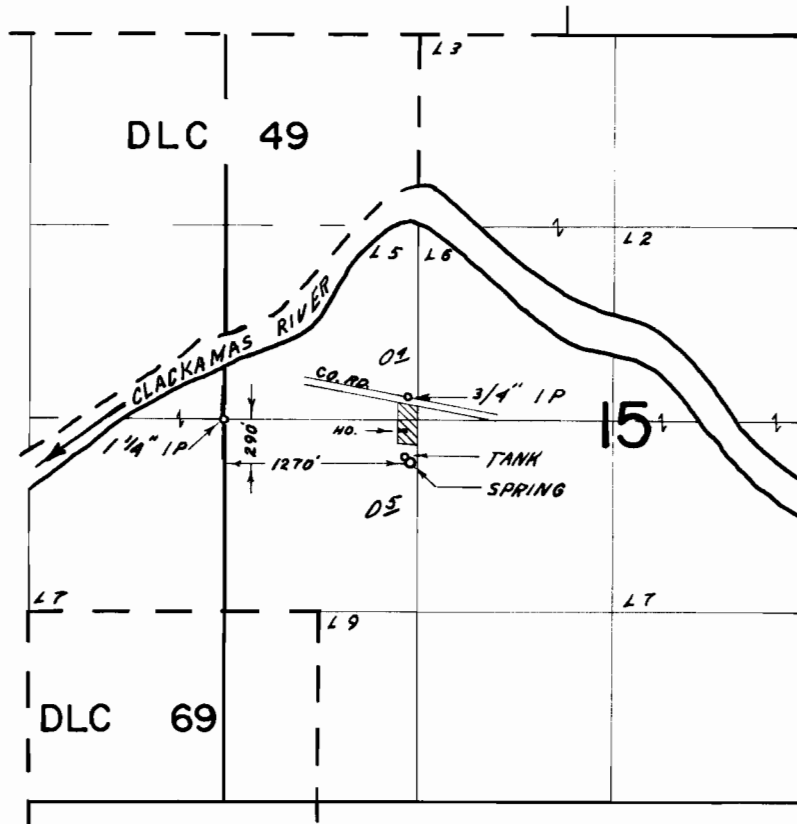

## FINAL PROOF SURVEY UNDER

Application No. 42086... Permit No. 31495...  
IN NAME OF

...ROBERT W. GROSSNICKLE...

Surveyed SEP. 29, 1970, by G. BAGA.....