


T. 1 S., R. 2 W., W.M.

CANCELLED

Hills

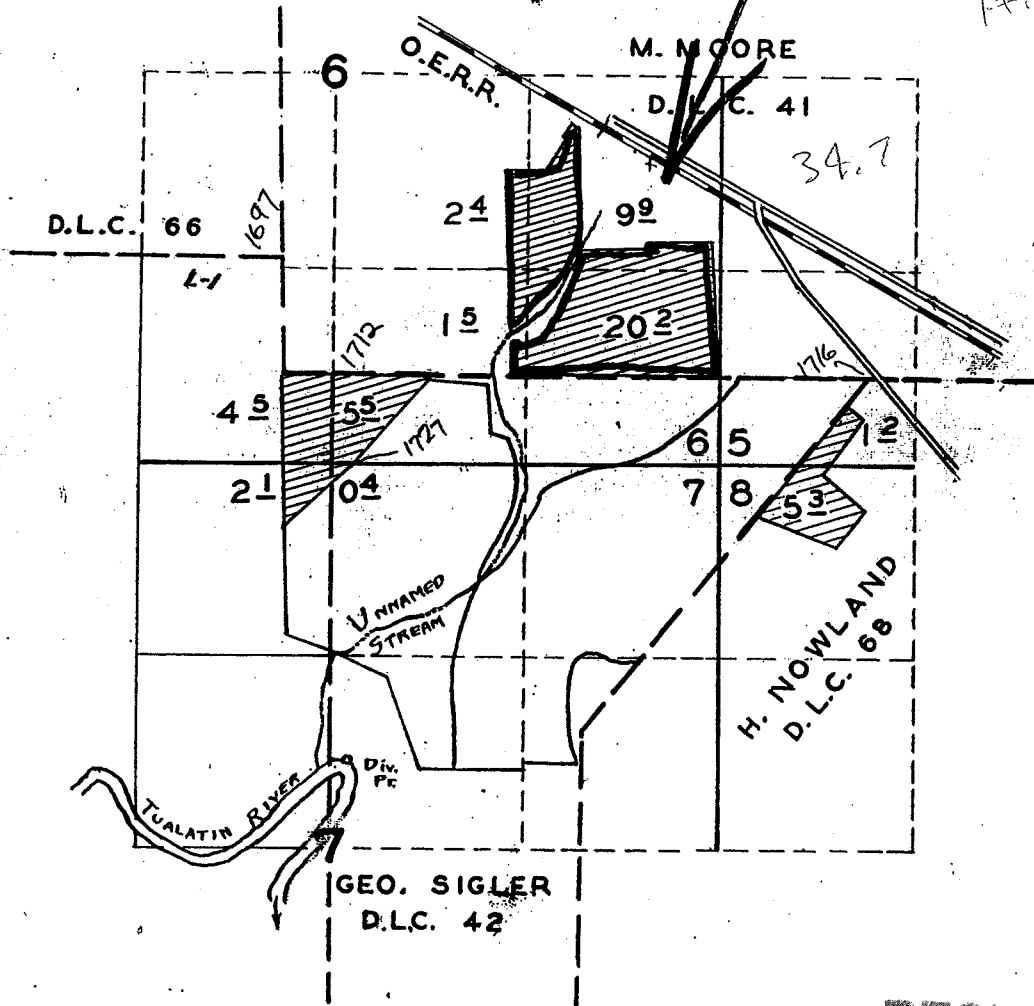

FINAL PROOF SURVEY
UNDER

Application No. 25611 Permit No. 20093
IN NAME OF

E. H. FREUDENTHAL

Surveyed 4-24-1956, by M. BISH

RECEIVED

AUG 07 2007

WATER RESOURCES DEPT
SALEM, OREGON