


T. 8 S. R. 40 E. W. M.

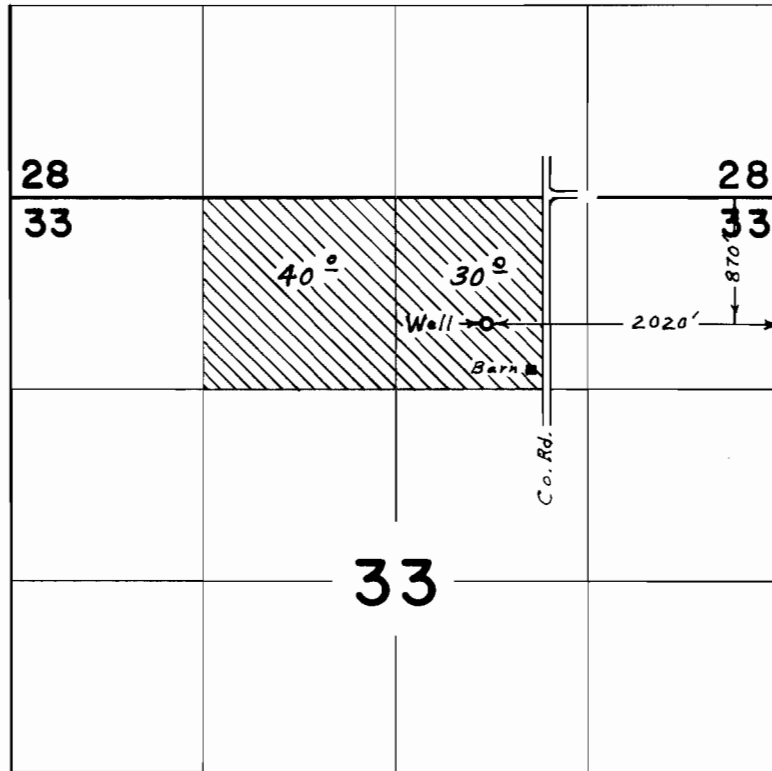

FINAL PROOF SURVEY
UNDER

Application No. G-3763 Permit No. G-3549
IN NAME OF

WILLIAM E. WIDMAN

Surveyed July 18, 1970, by L. E. Gould