


T. 9 S. R. 40 E. W. M. .

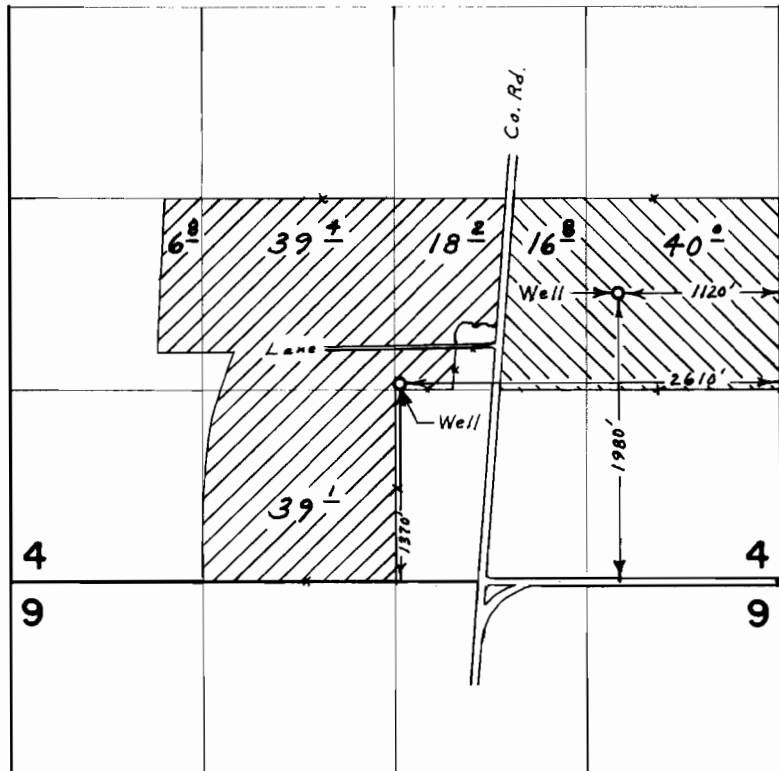

FINAL PROOF SURVEY
UNDER

G-3764 G-3550
Application No. G-3765 Permit No. G-3551
IN NAME OF

WILLIAM E. WIDMAN

Surveyed Aug. 4, 1970, by L. E. Gould