


T. 14 S. R. 4 & 5 W. W. M

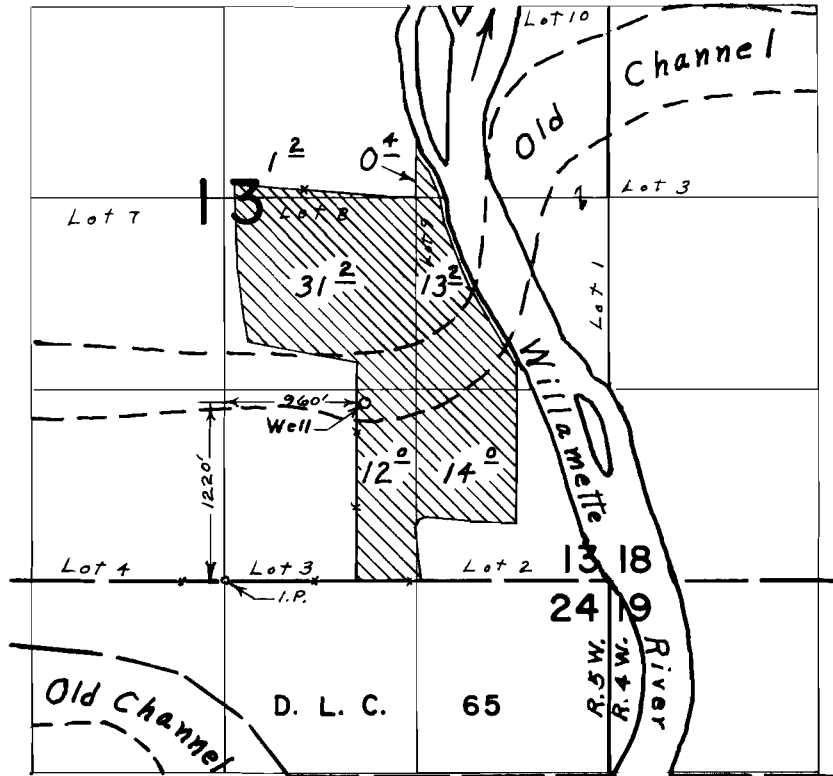

FINAL PROOF SURVEY UNDER

Application No. G-4124 Permit No. G-3880
IN NAME OF

VOLNEY VOLKER

Surveyed April 7, 1970, by L. E. Gould