


T. 3 S. R. 1 W. W. M.

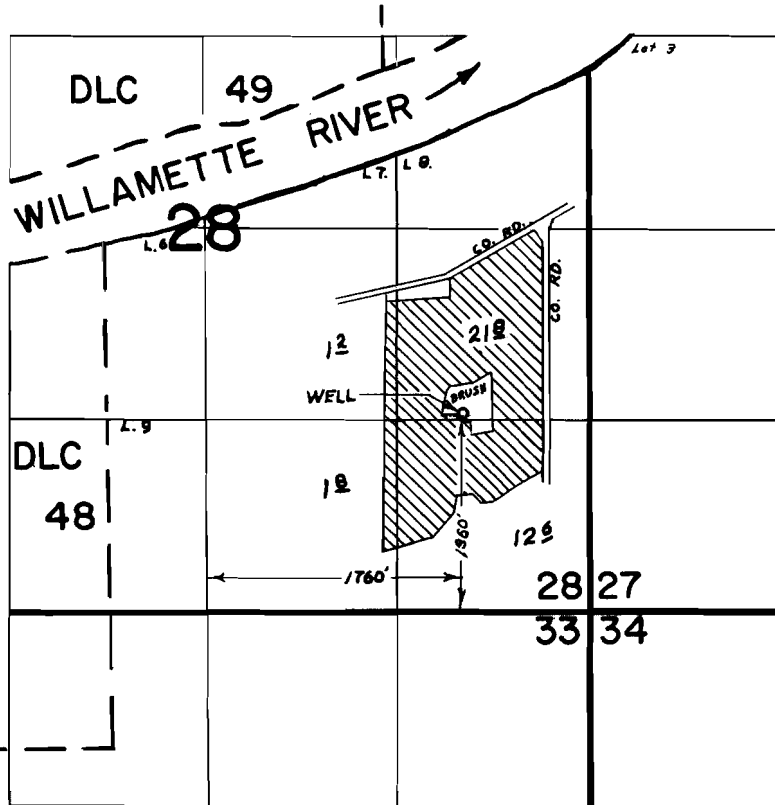

FINAL PROOF SURVEY
UNDER

Application No. G-2895. Permit No. G-2727.
IN NAME OF

.....EMERY JONES.....

Surveyed AUG. 20, 1971., by R. MUCKEN.....