


T.5S.R.IE.W.M.

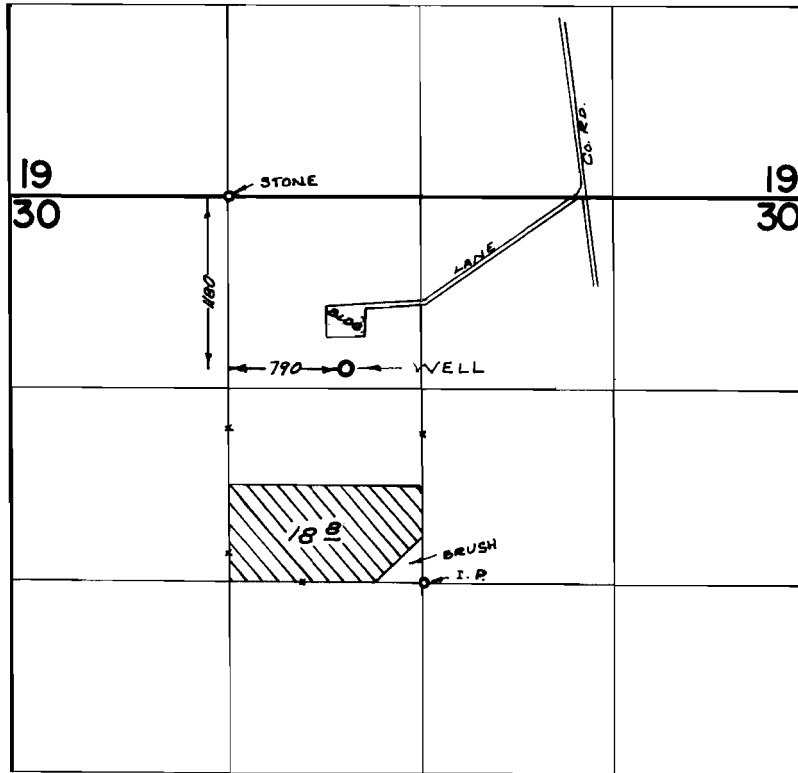

FINAL PROOF SURVEY UNDER

Application No. *G-3330* Permit No. *G-3111*
IN NAME OF

GEORGE E. BOND

Surveyed *APR. 26, 1971*, by *R. MUCKEN*.