


T 4 S R I E . W . M .

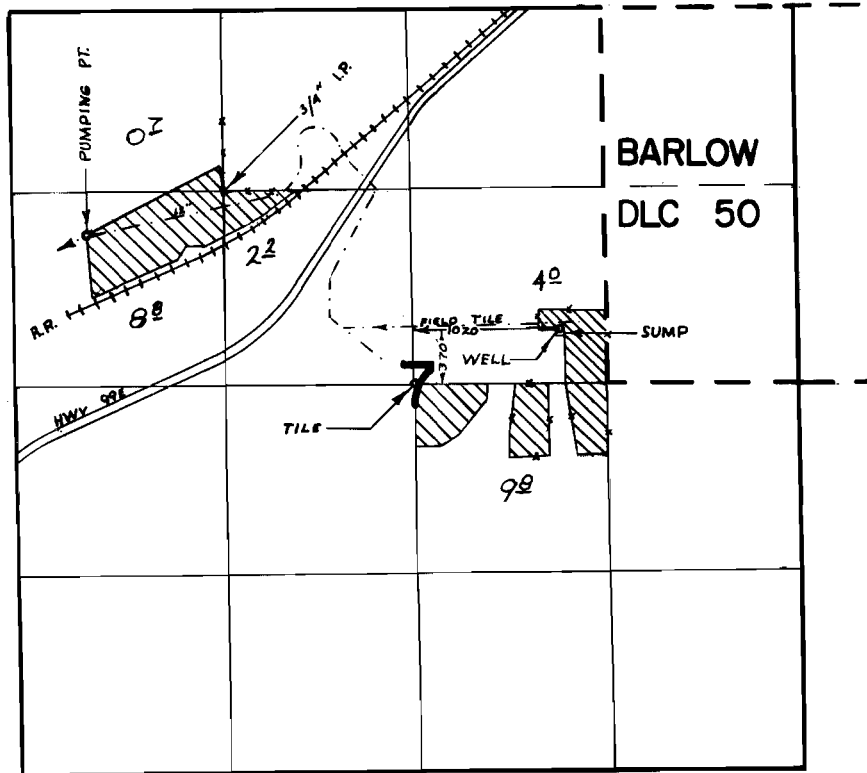

FINAL PROOF SURVEY UNDER

Application No. G-3852 Permit No. G-3628
IN NAME OF

WAYNE WILLIS YODER

Surveyed JUNE 4, 1971, by R. MUCKEN