


T. 3 & 4 S. R. 1 E. W. M.

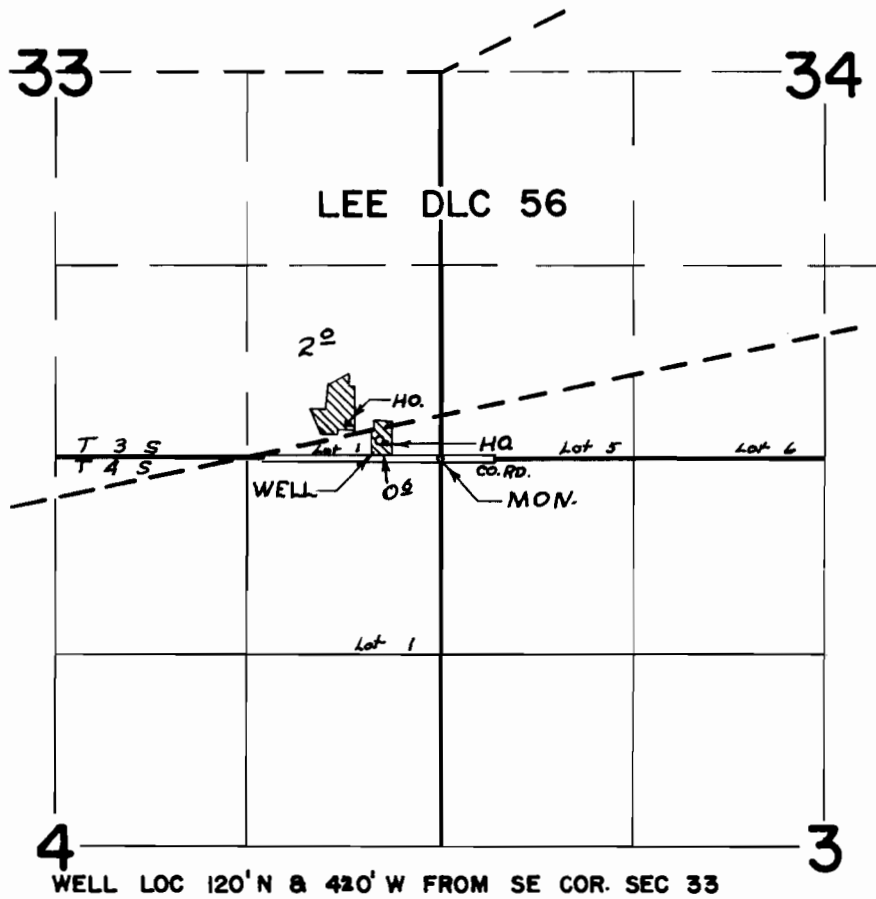

FINAL PROOF SURVEY UNDER

Application No. G. 4000. Permit No. G. 3752.
IN NAME OF

CARL F. & WALTER O. SCHMEISER

Surveyed AUG. 20. 1971., by R. MUCKEN