


# T.3S.R.1E.W.M.

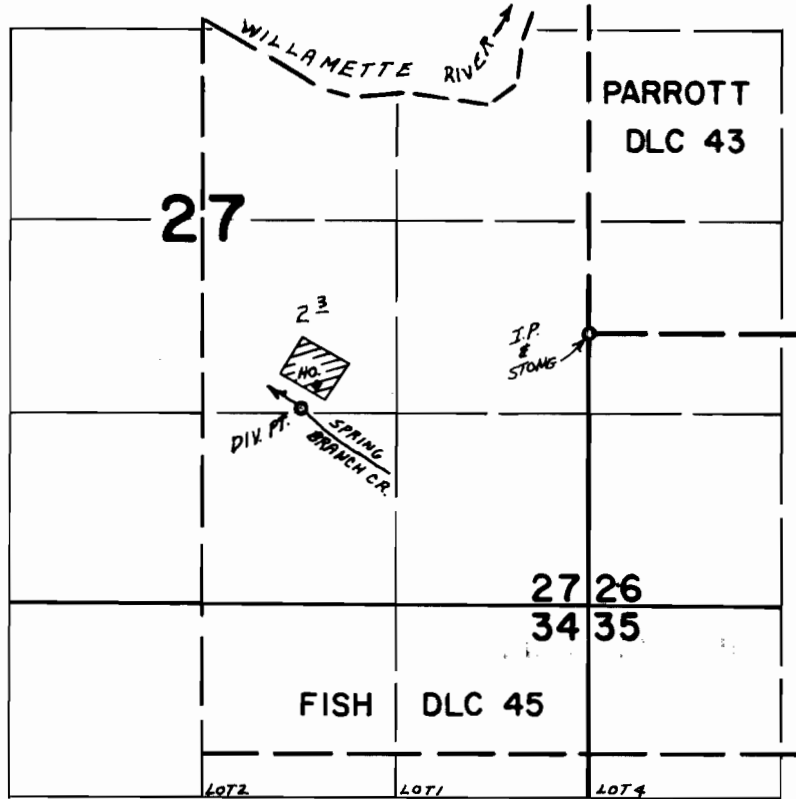

DIV. PT. LOC. 530' S. & 1970' W. FROM SW COR. PARROTT DLC 43

## FINAL PROOF SURVEY UNDER

Application No. 12519 Permit No. 31213  
IN NAME OF

JOHN L. MASSEY & MARISE L. MASSEY

Surveyed NOV. 18 1970, by L. E. GOULD